


PARENT PARCEL: 06-23-009-102-042
 CHILD PARCEL: 06-23-009-102-074, 075
 STARTING POINT: c.l. of Freedom Ct. & c.l. of Schaden Rd.

NO. 22338

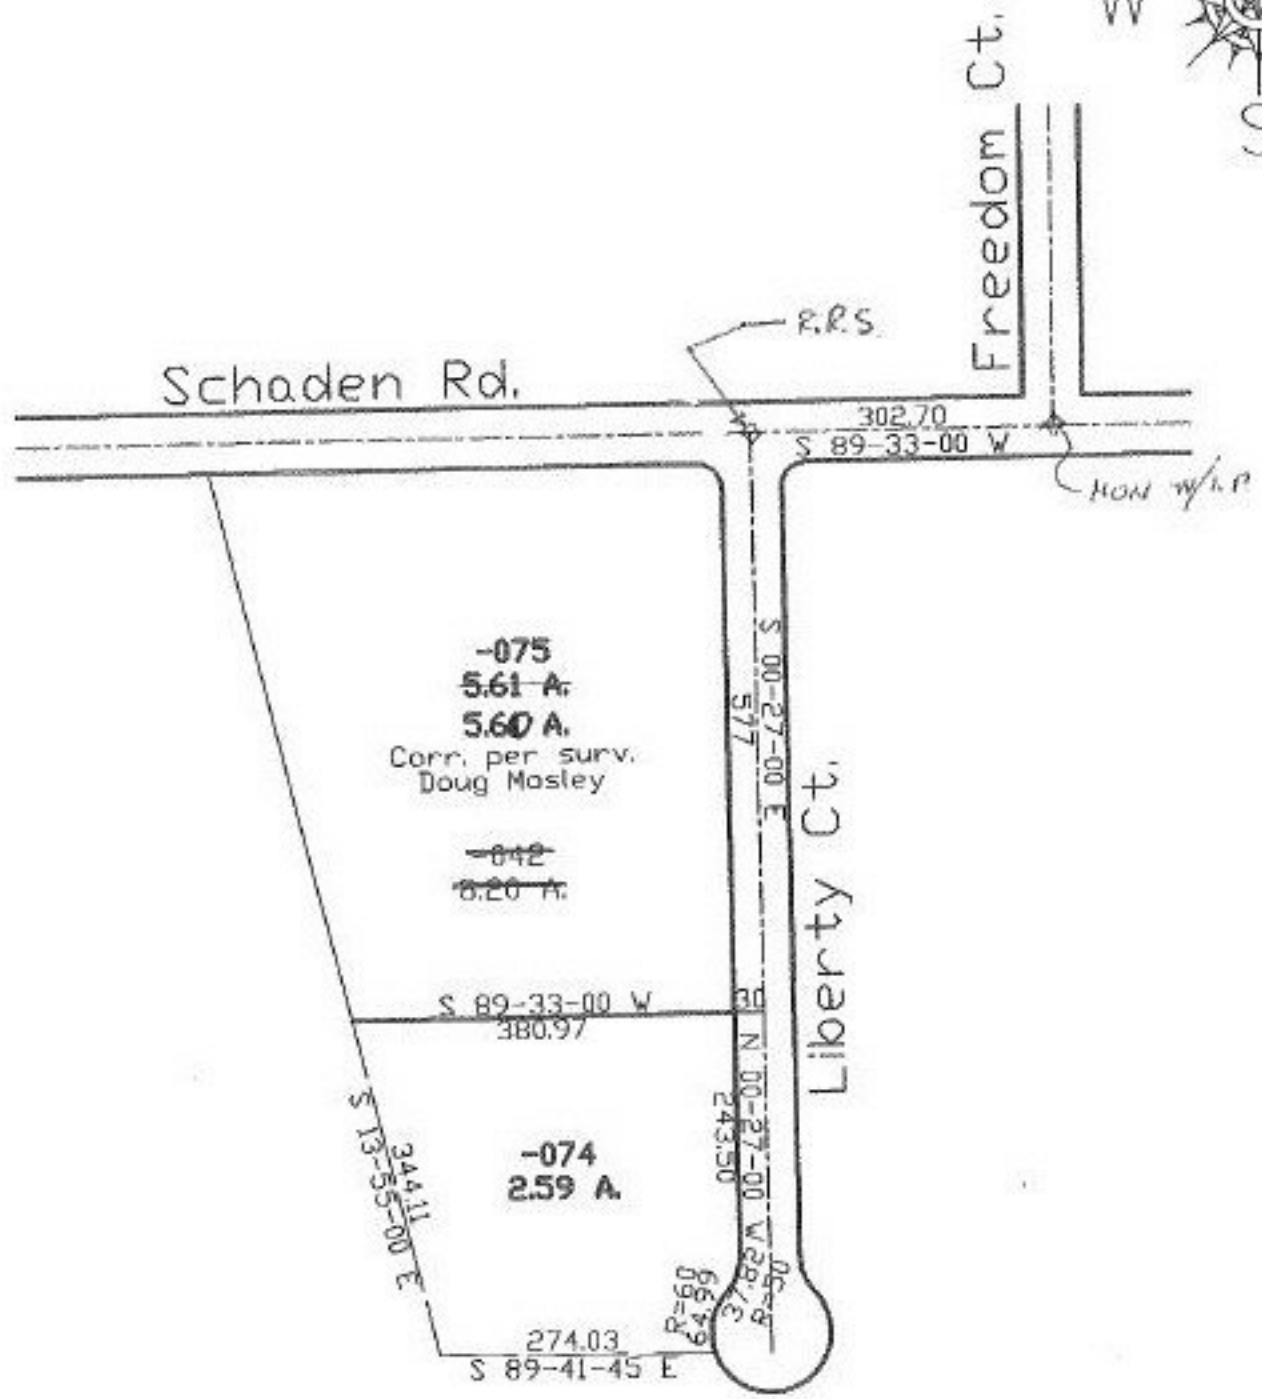

DP 9-23-98

SPLITS/DEEDS PROCESSED
 LORAIN COUNTY TAX MAP DEPARTMENT
 226 MIDDLE AVE. ELYRIA, OHIO

SURVEYED BY: Doug Masley for Benjamin
 CLOSURE: 0.02:10.000
 MAP PAGE(S): 6-25
 APPROVED BY: kac DATE: 01/31/97
 SCALE: 1" = 200' PRIOR INSTRUMENT: plat 36/B