
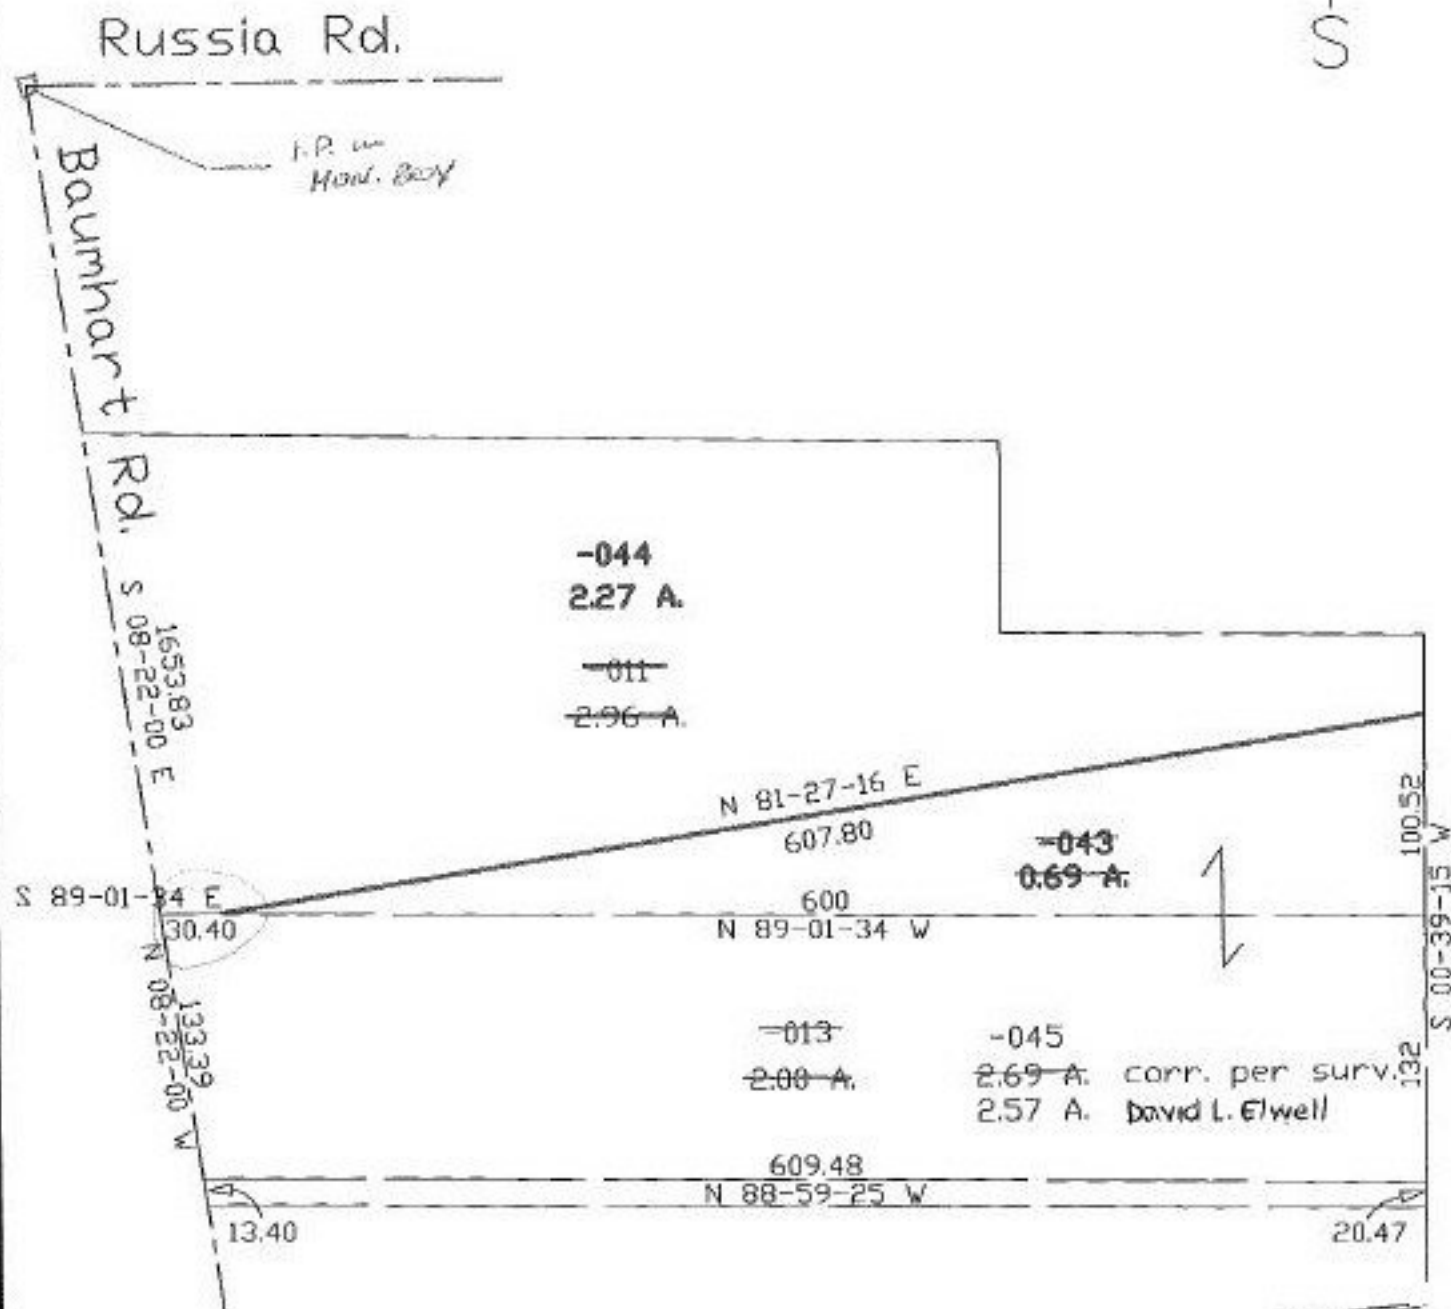


PARENT PARCEL: 08-00-103-000-011, 013
 CHILD PARCEL: 08-00-103-000-043, 044, 045
 STARTING POINT: c.l. of Russia Rd. & c.l. of Baumhart Rd.

NO. 22341

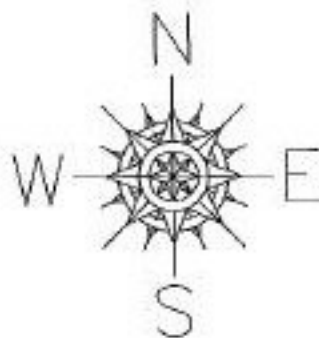

SPLITS/DEEDS PROCESSED
 LORAIN COUNTY TAX MAP DEPARTMENT
 226 MIDDLE AVE. ELYRIA, OHIO

SURVEYED BY: David L. Elwell
 CLOSURE: 0.07:10.000
 MAP PAGE(S): 8-0 DATE: 11/3/97
 APPROVED BY: kac SCALE: 1" = 100'
 PRIOR INSTRUMENT: OR 789/906 OR 699/707