
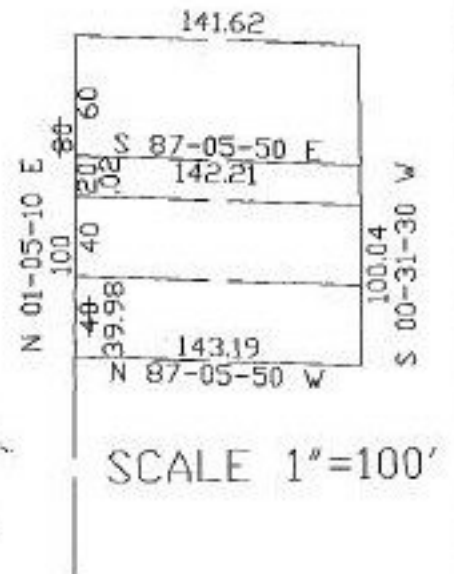


PARENT PARCEL: 06-25-016-105-003, 004, 005
 CHILD PARCEL: 06-25-016-105-050, 051
 STARTING POINT: cl. of Clark St. & cl. of Prospect St.

NO. 22342

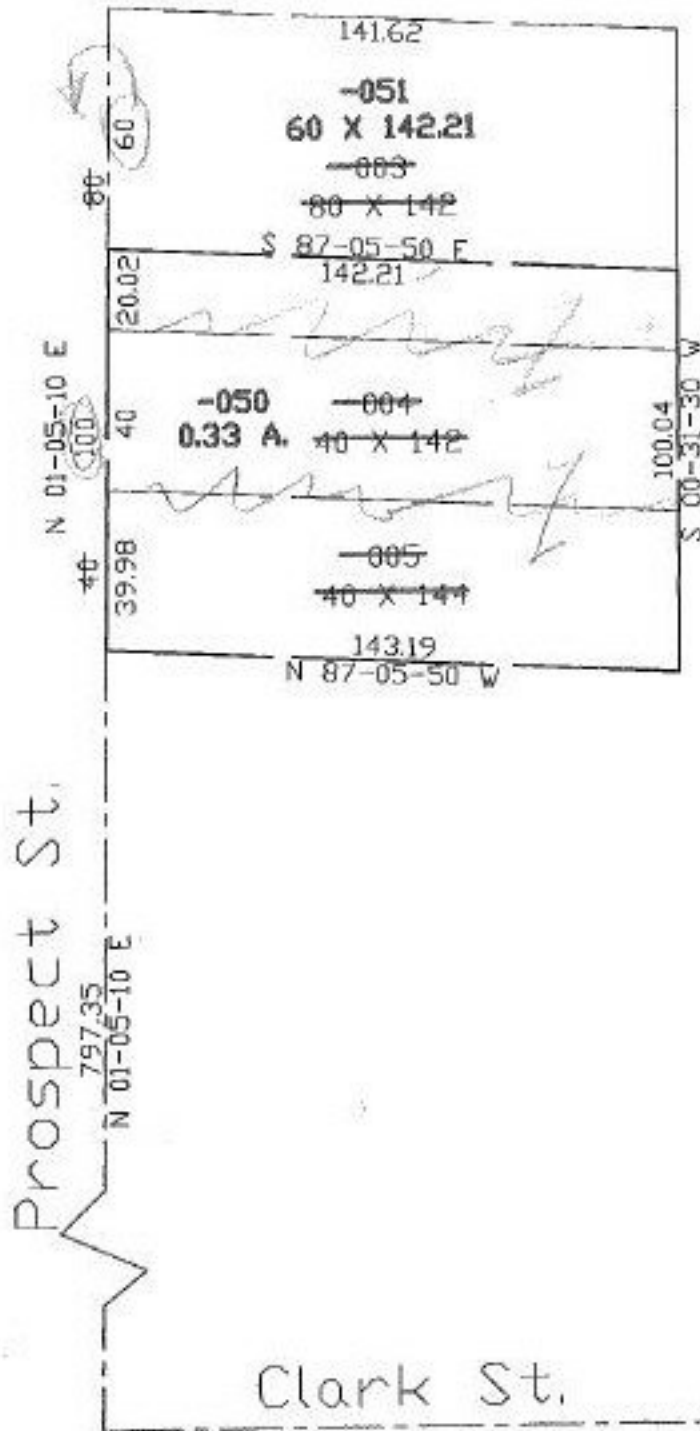

DP 9/29/98

SPLITS/DEEDS PROCESSED

LORAIN COUNTY TAX MAP DEPARTMENT
 226 MIDDLE AVE. ELYRIA, OHIO

SURVEYED BY: David L. Ewell
 CLOSURE: 0.09:10.000
 MAP PAGE(S): 6-105
 APPROVED BY: kac DATE: 11/1/97
 SCALE: 1"=50 PRIOR INSTRUMENT: 570/342

MYLAR CK'D 11-9-98 TH

CK'D 11/29/98 TH