

22343
NO. 22343

PARENT PARCEL: 04-00-007-150-007, 008, 009, 035 *** see below ***

CHILD PARCEL: 04-00-007-150-082, 083, 04-00-008-101-049


STARTING POINT: c.l. of Walker Rd. & c.l. of Moore Rd.

*** Parent par. cont. 04-00-008-101-005, 025, 026, 038, 04-00-008-102-001, 003, 004, 005, 007 thru 011, 04-00-008-103-001, 002

UPDATE
LEGAL



Prior Instruments:
970485733
970493583

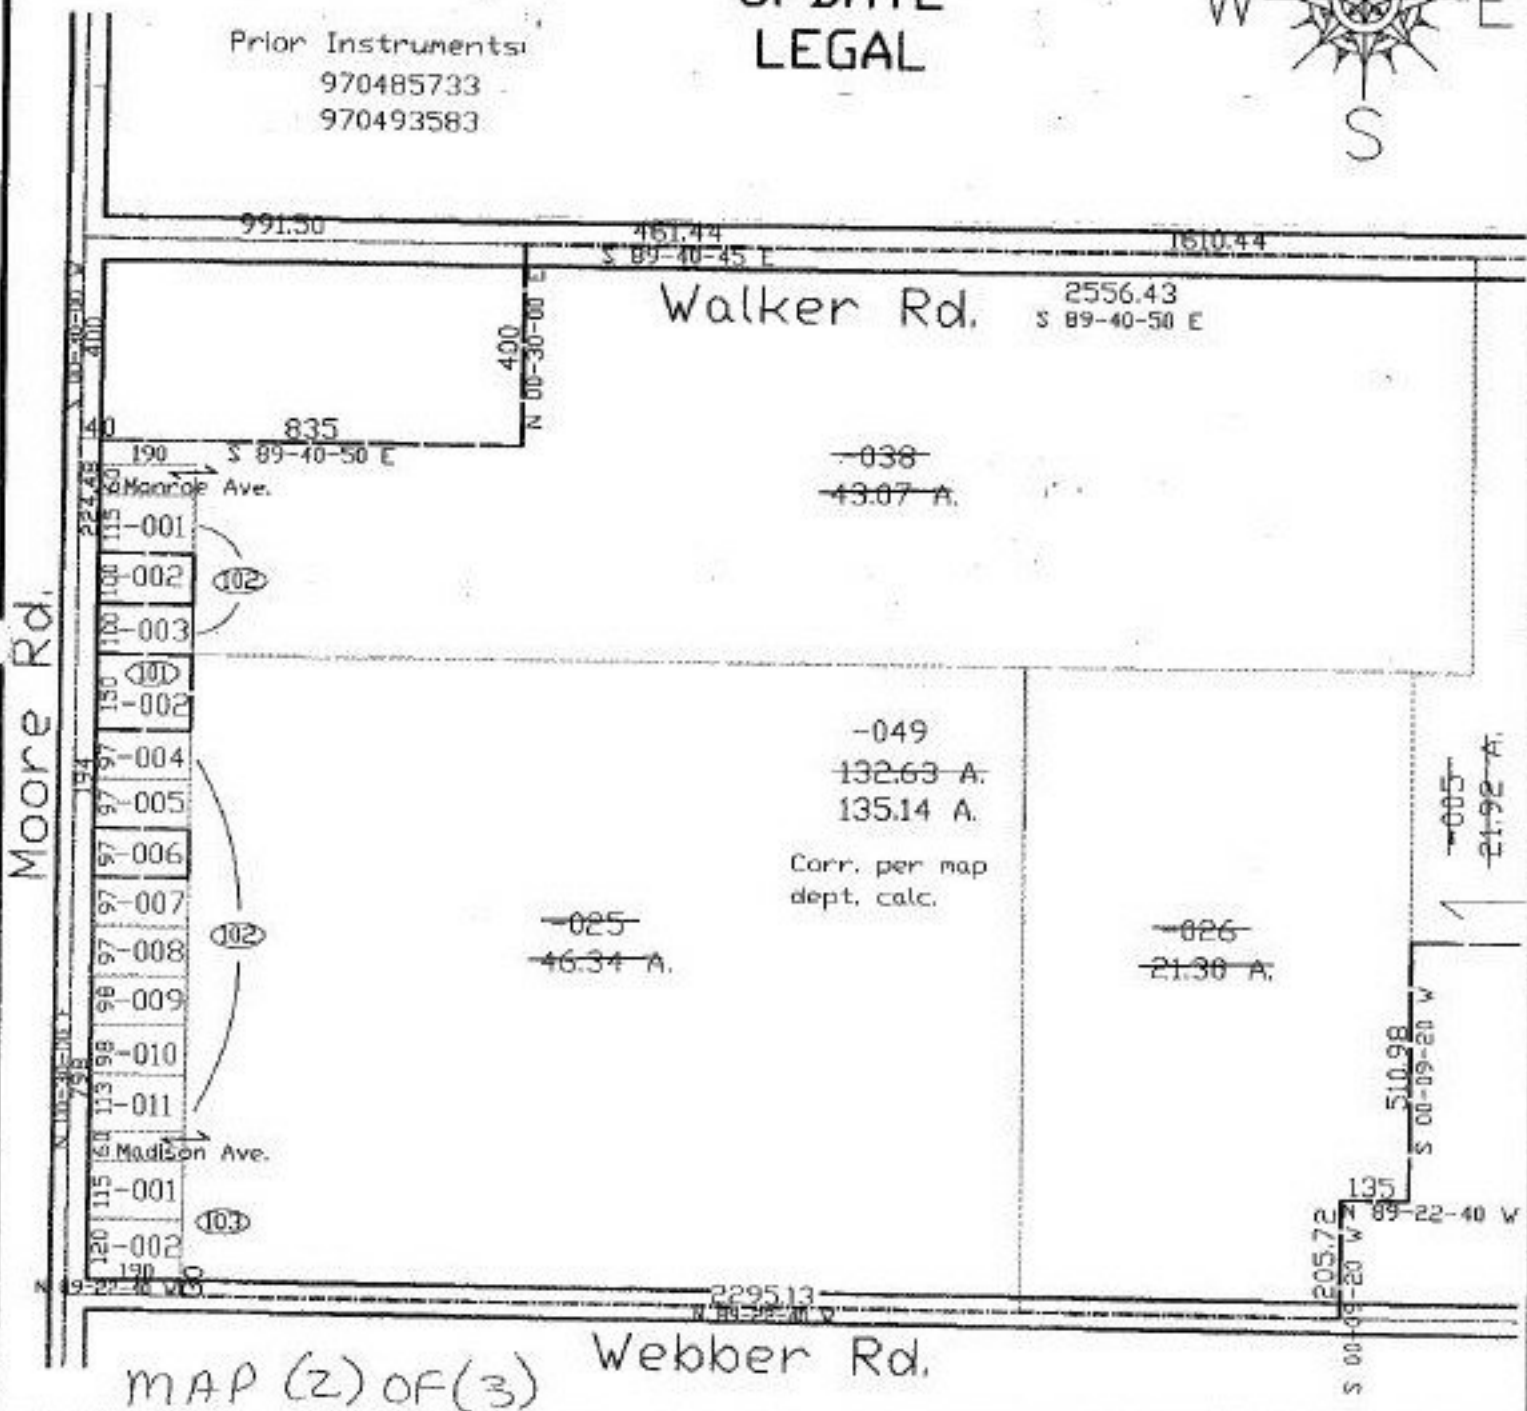

MAP (2) OF (3)



SPLITS/DEEDS PROCESSED
LORAIN COUNTY TAX MAP DEPARTMENT
226 MIDDLE AVE. ELYRIA, OHIO

SURVEYED BY: Donald E. Woike
 CLOSURE: 0.01:10,000
 MAP PAGE(S): 4-B, 04-00-007-EFG, 04-00-008-AB
 APPROVED BY: kec DATE: 11/6/97
 SCALE: 1" = 400' PRIOR INSTRUMENT: