

22343

PARENT PARCEL: 04-00-007-150-007, 008, 009, 035 *** see below ***


CHILD PARCEL: 04-00-007-150-082, 083, 04-00-008-101-049

STARTING POINT: c.l. of Walker Rd. & c.l. of Moore Rd.

NO. 22343

*** Parent par. cont. 04-00-008-101-005, 025, 026, 038, 04-00-008-102-001, 003, 004, 005, 007 thru 011, 04-00-008-103-001, 002

UPDATE LEGAL

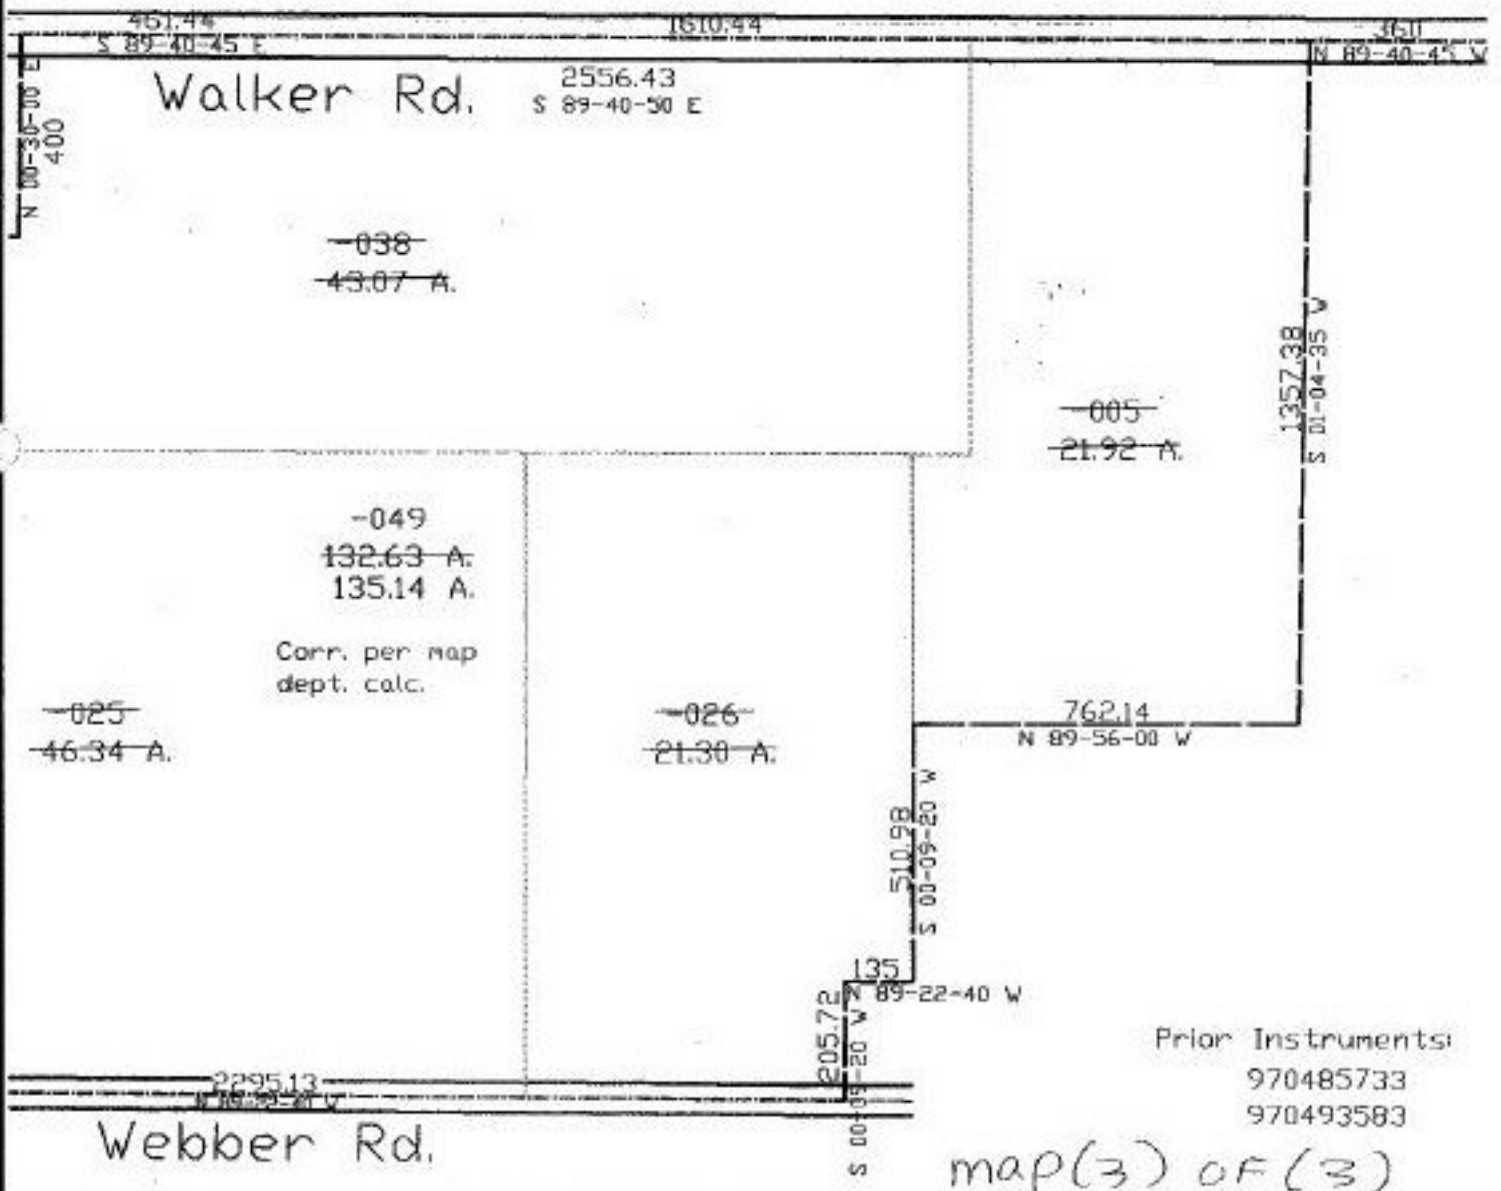

Prior Instruments:
970485733
970493583

map(3) of (3)



SPLITS/DEEDS PROCESSED
LORAIN COUNTY TAX MAP DEPARTMENT
226 MIDDLE AVE. ELYRIA, OHIO

SURVEYED BY: Donald E. Woike
CLOSURE: 0.01:10,000
MAP PAGE(S): 4-B, 04-00-007-EFG, 04-00-008-AB
APPROVED BY: koc DATE: 11/6/97
SCALE: 1" = 400' PRIOR INSTRUMENT: