


#22344  
NO. 22344

PARENT PARCEL: 11-00-035-000-015, 038  
CHILD PARCEL: 11-00-035-000-040, 041, 042  
STARTING POINT: N. Line of O.L. 35 & cl. of Island Rd.



North line of O.L. 35

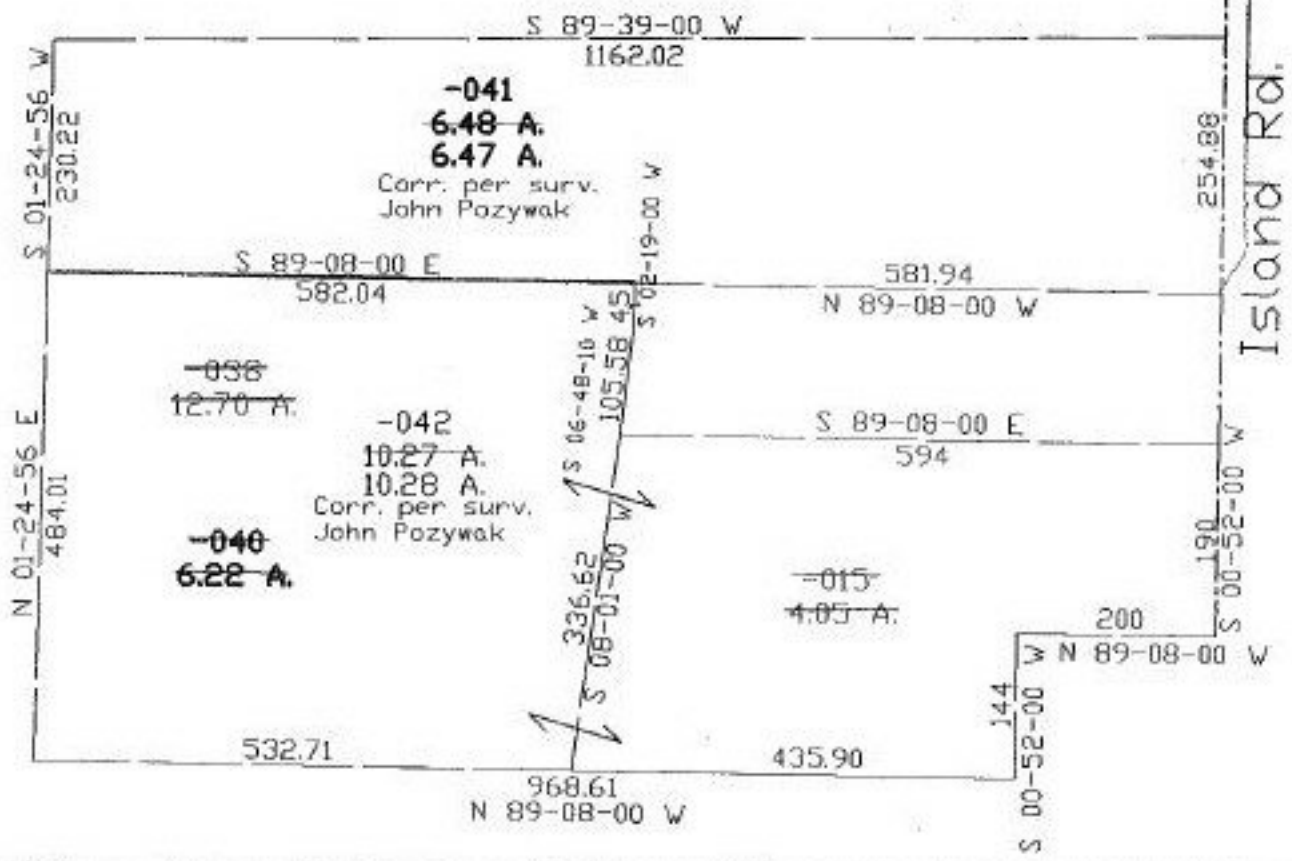

**SPLITS/DEEDS PROCESSED**  
LORAIN COUNTY TAX MAP DEPARTMENT  
226 MIDDLE AVE. ELYRIA, OHIO

SURVEYED BY: John Poznyak  
CLOSURE: 0.08:10.000  
MAP PAGE(S): 11-C  
APPROVED BY: kac DATE: 11/6/97  
SCALE: 1" = 200' PRIOR INSTRUMENT.