

PARENT PARCEL: 10-005-107-129, 374, 375

CHILD PARCEL: 10-00-005-107-394 thru -404



STARTING POINT: c.l. of Highland Park Dr. & c.l. of Chestnut Ridge Rd.

NO. 22347

NE CORNER



Chestnut Ridge Rd.

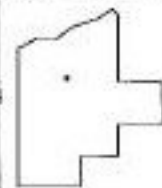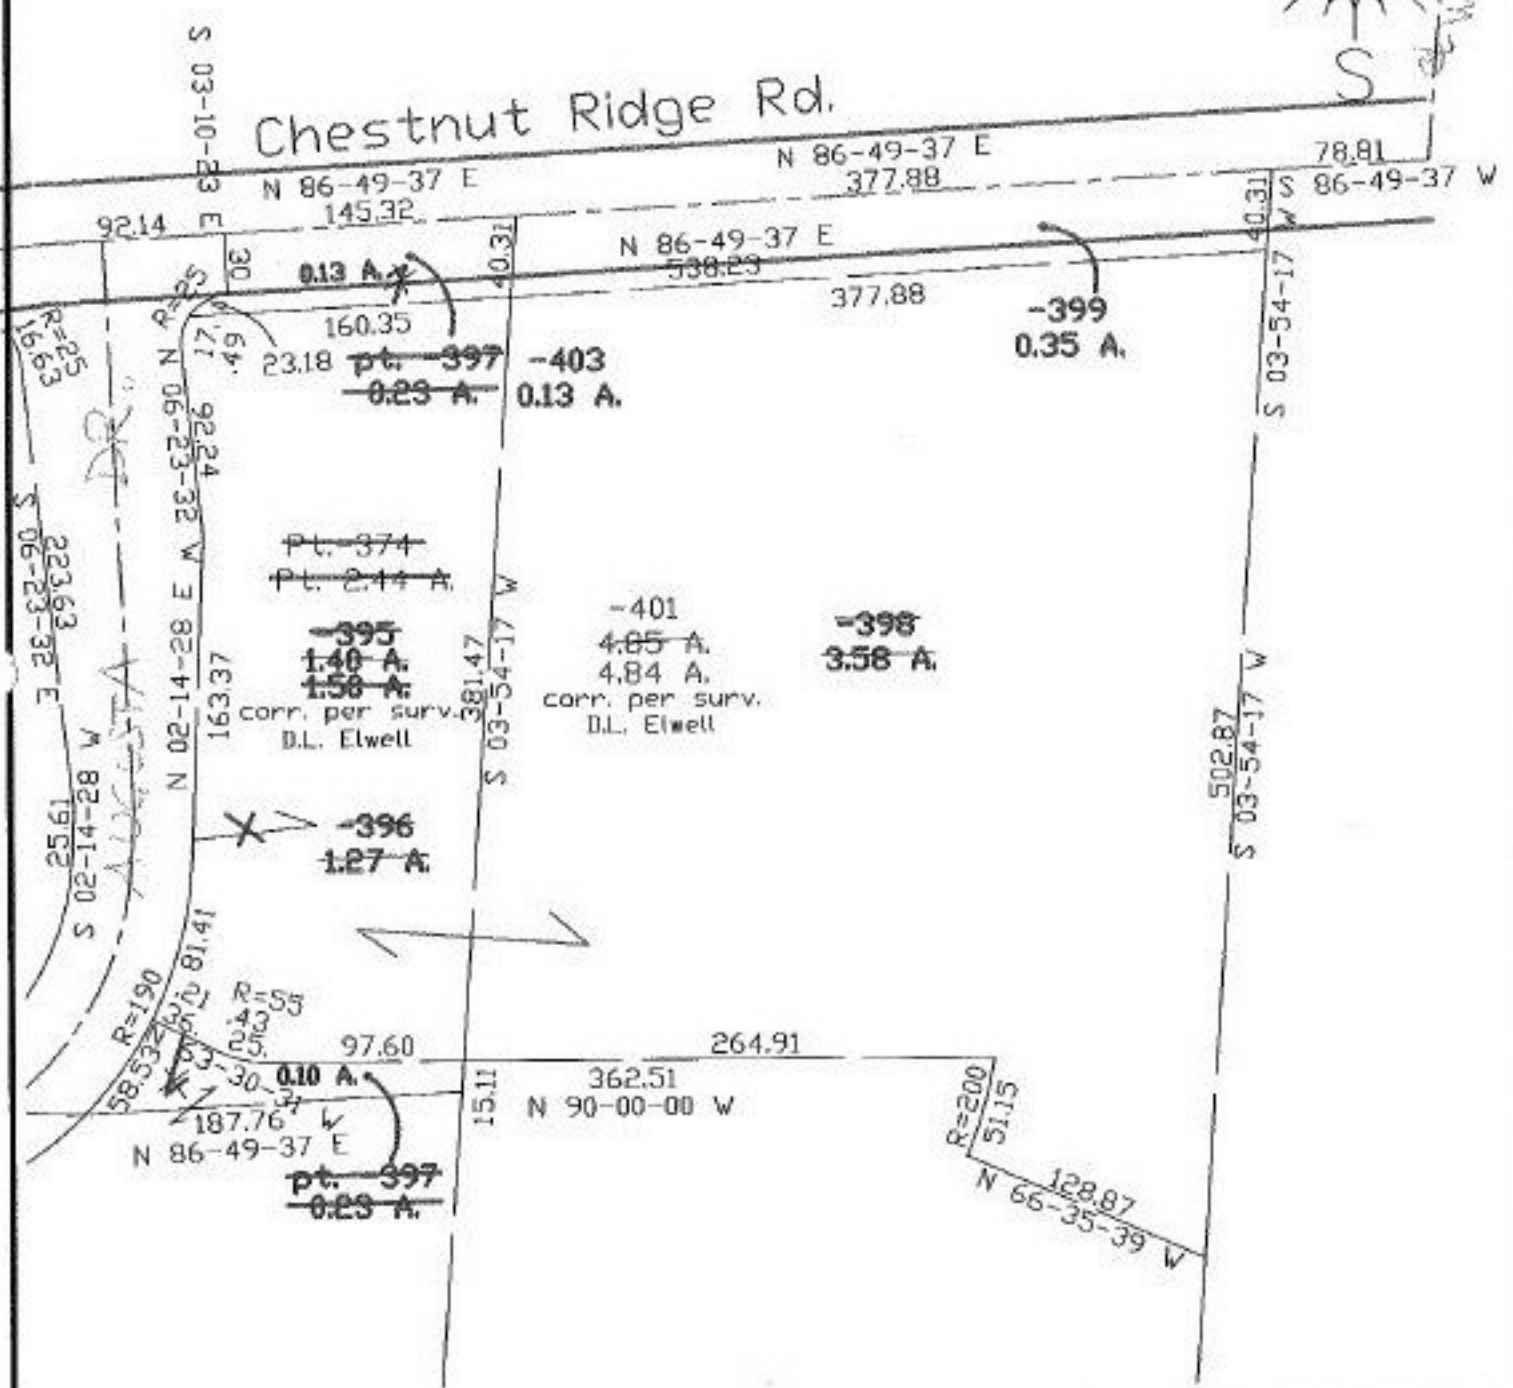

SPLITS/DEEDS PROCESSED
LORAIN COUNTY TAX MAP DEPARTMENT
226 MIDDLE AVE. ELYRIA, OHIO

SURVEYED BY: David L. Elwell
CLOSURE: 0.11:10.000
MAP PAGE(S): 10-00-005-E,F DATE: 1/9/98
APPROVED BY: kac SCALE: 1" = 100'
PRIOR INSTRUMENT: OR 1422/697 OR 782/391