
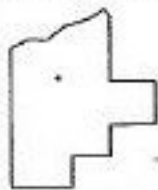


PARENT PARCEL: 04-00-024-105-138

CHILD PARCEL: 04-00-024-105-039, 04-00-024-111-081, 082, 083, 04-00-025-900-025

STARTING POINT: c.l. of Saint Marion Blvd. & c.l. of Jaycox Rd.

NO. 22348

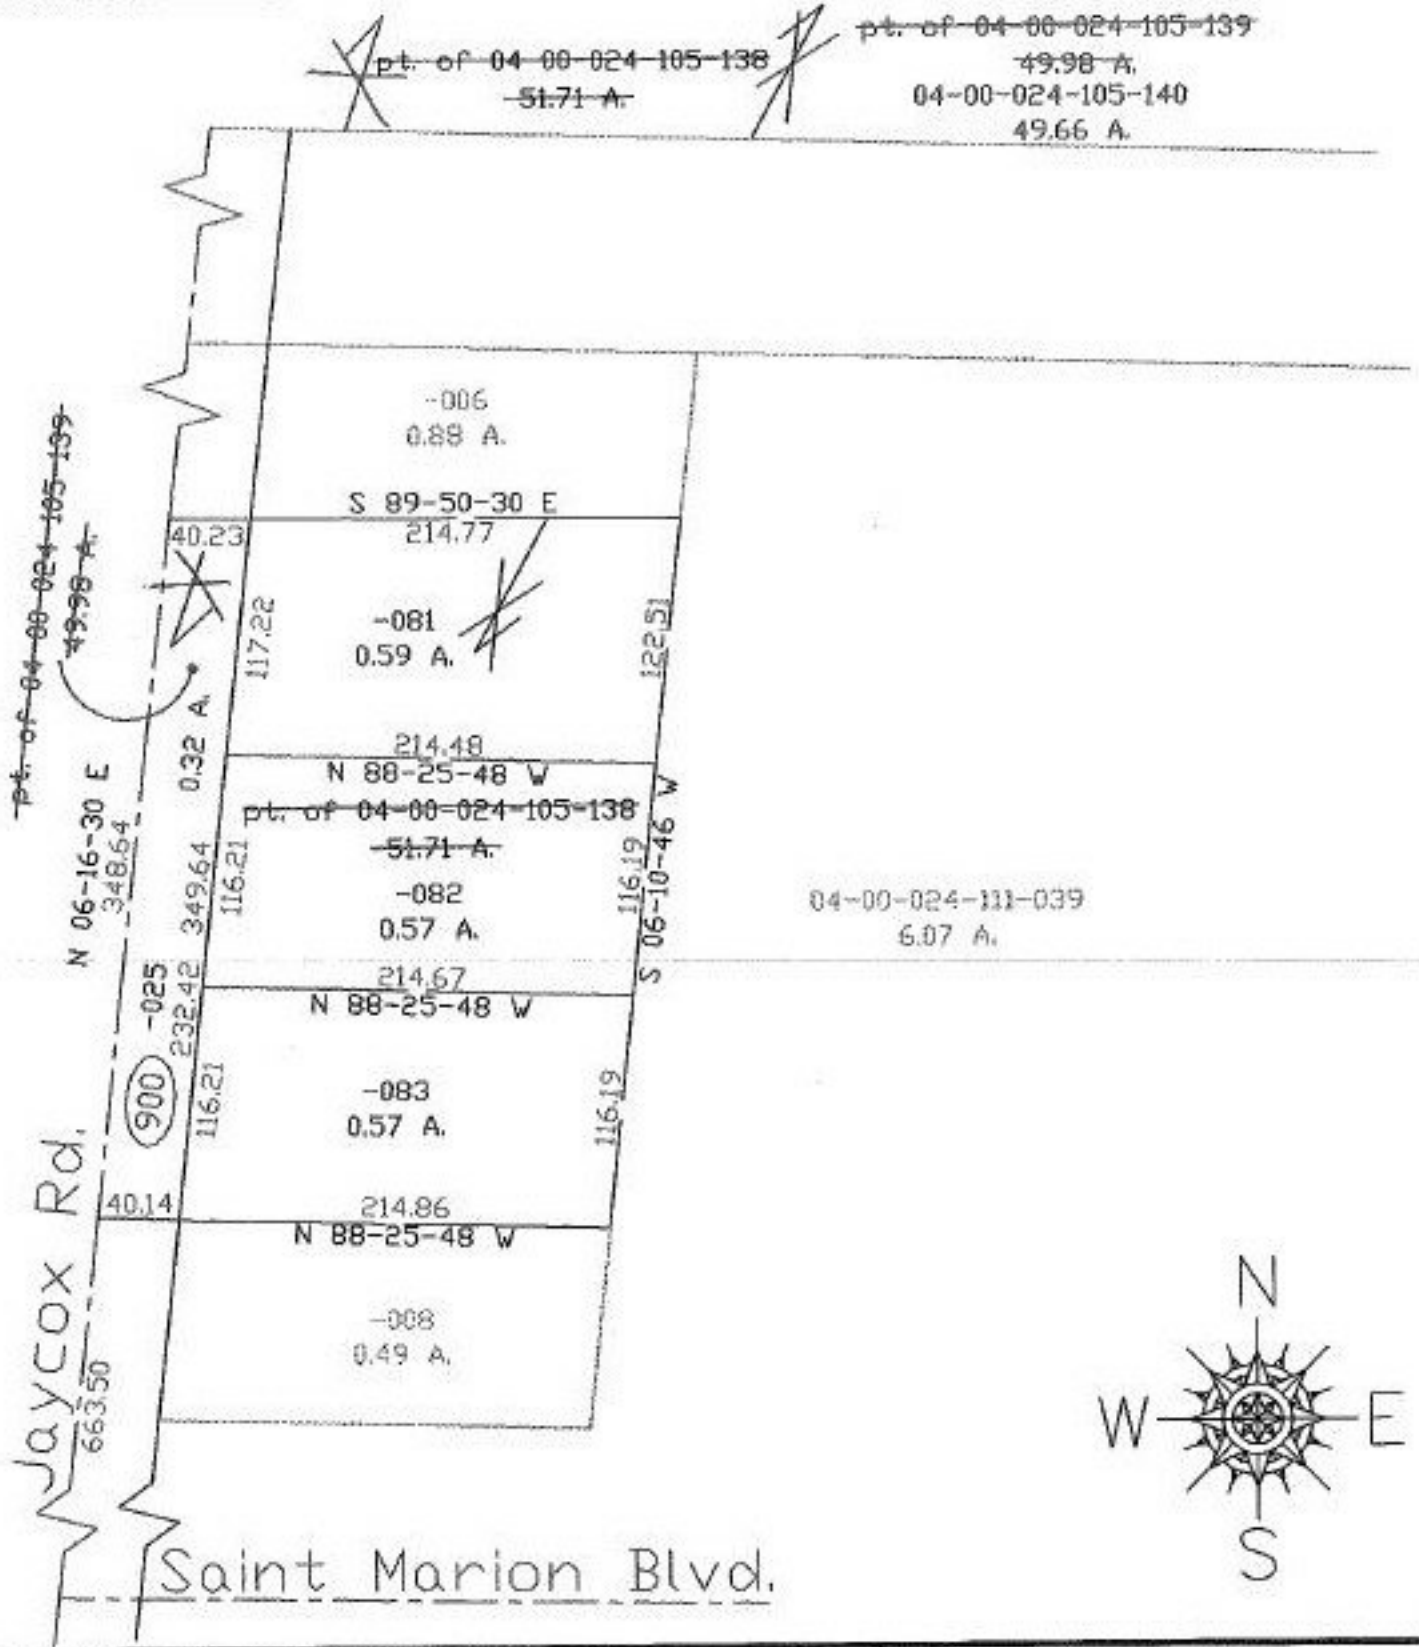

SPLITS/DEEDS PROCESSED
 LORAIN COUNTY TAX MAP DEPARTMENT
 226 MIDDLE AVE. ELYRIA, OHIO

SURVEYED BY: Richard A. Thompson, Jr.
 CLOSURE: 0:10:10,000
 MAP PAGE(S): 04-00-024-F
 APPROVED BY: kas DATE: 3/11/98
 SCALE: 1" = 100' PRIOR INSTRUMENT: 911/811