


WOOSTER-AVON LAKE

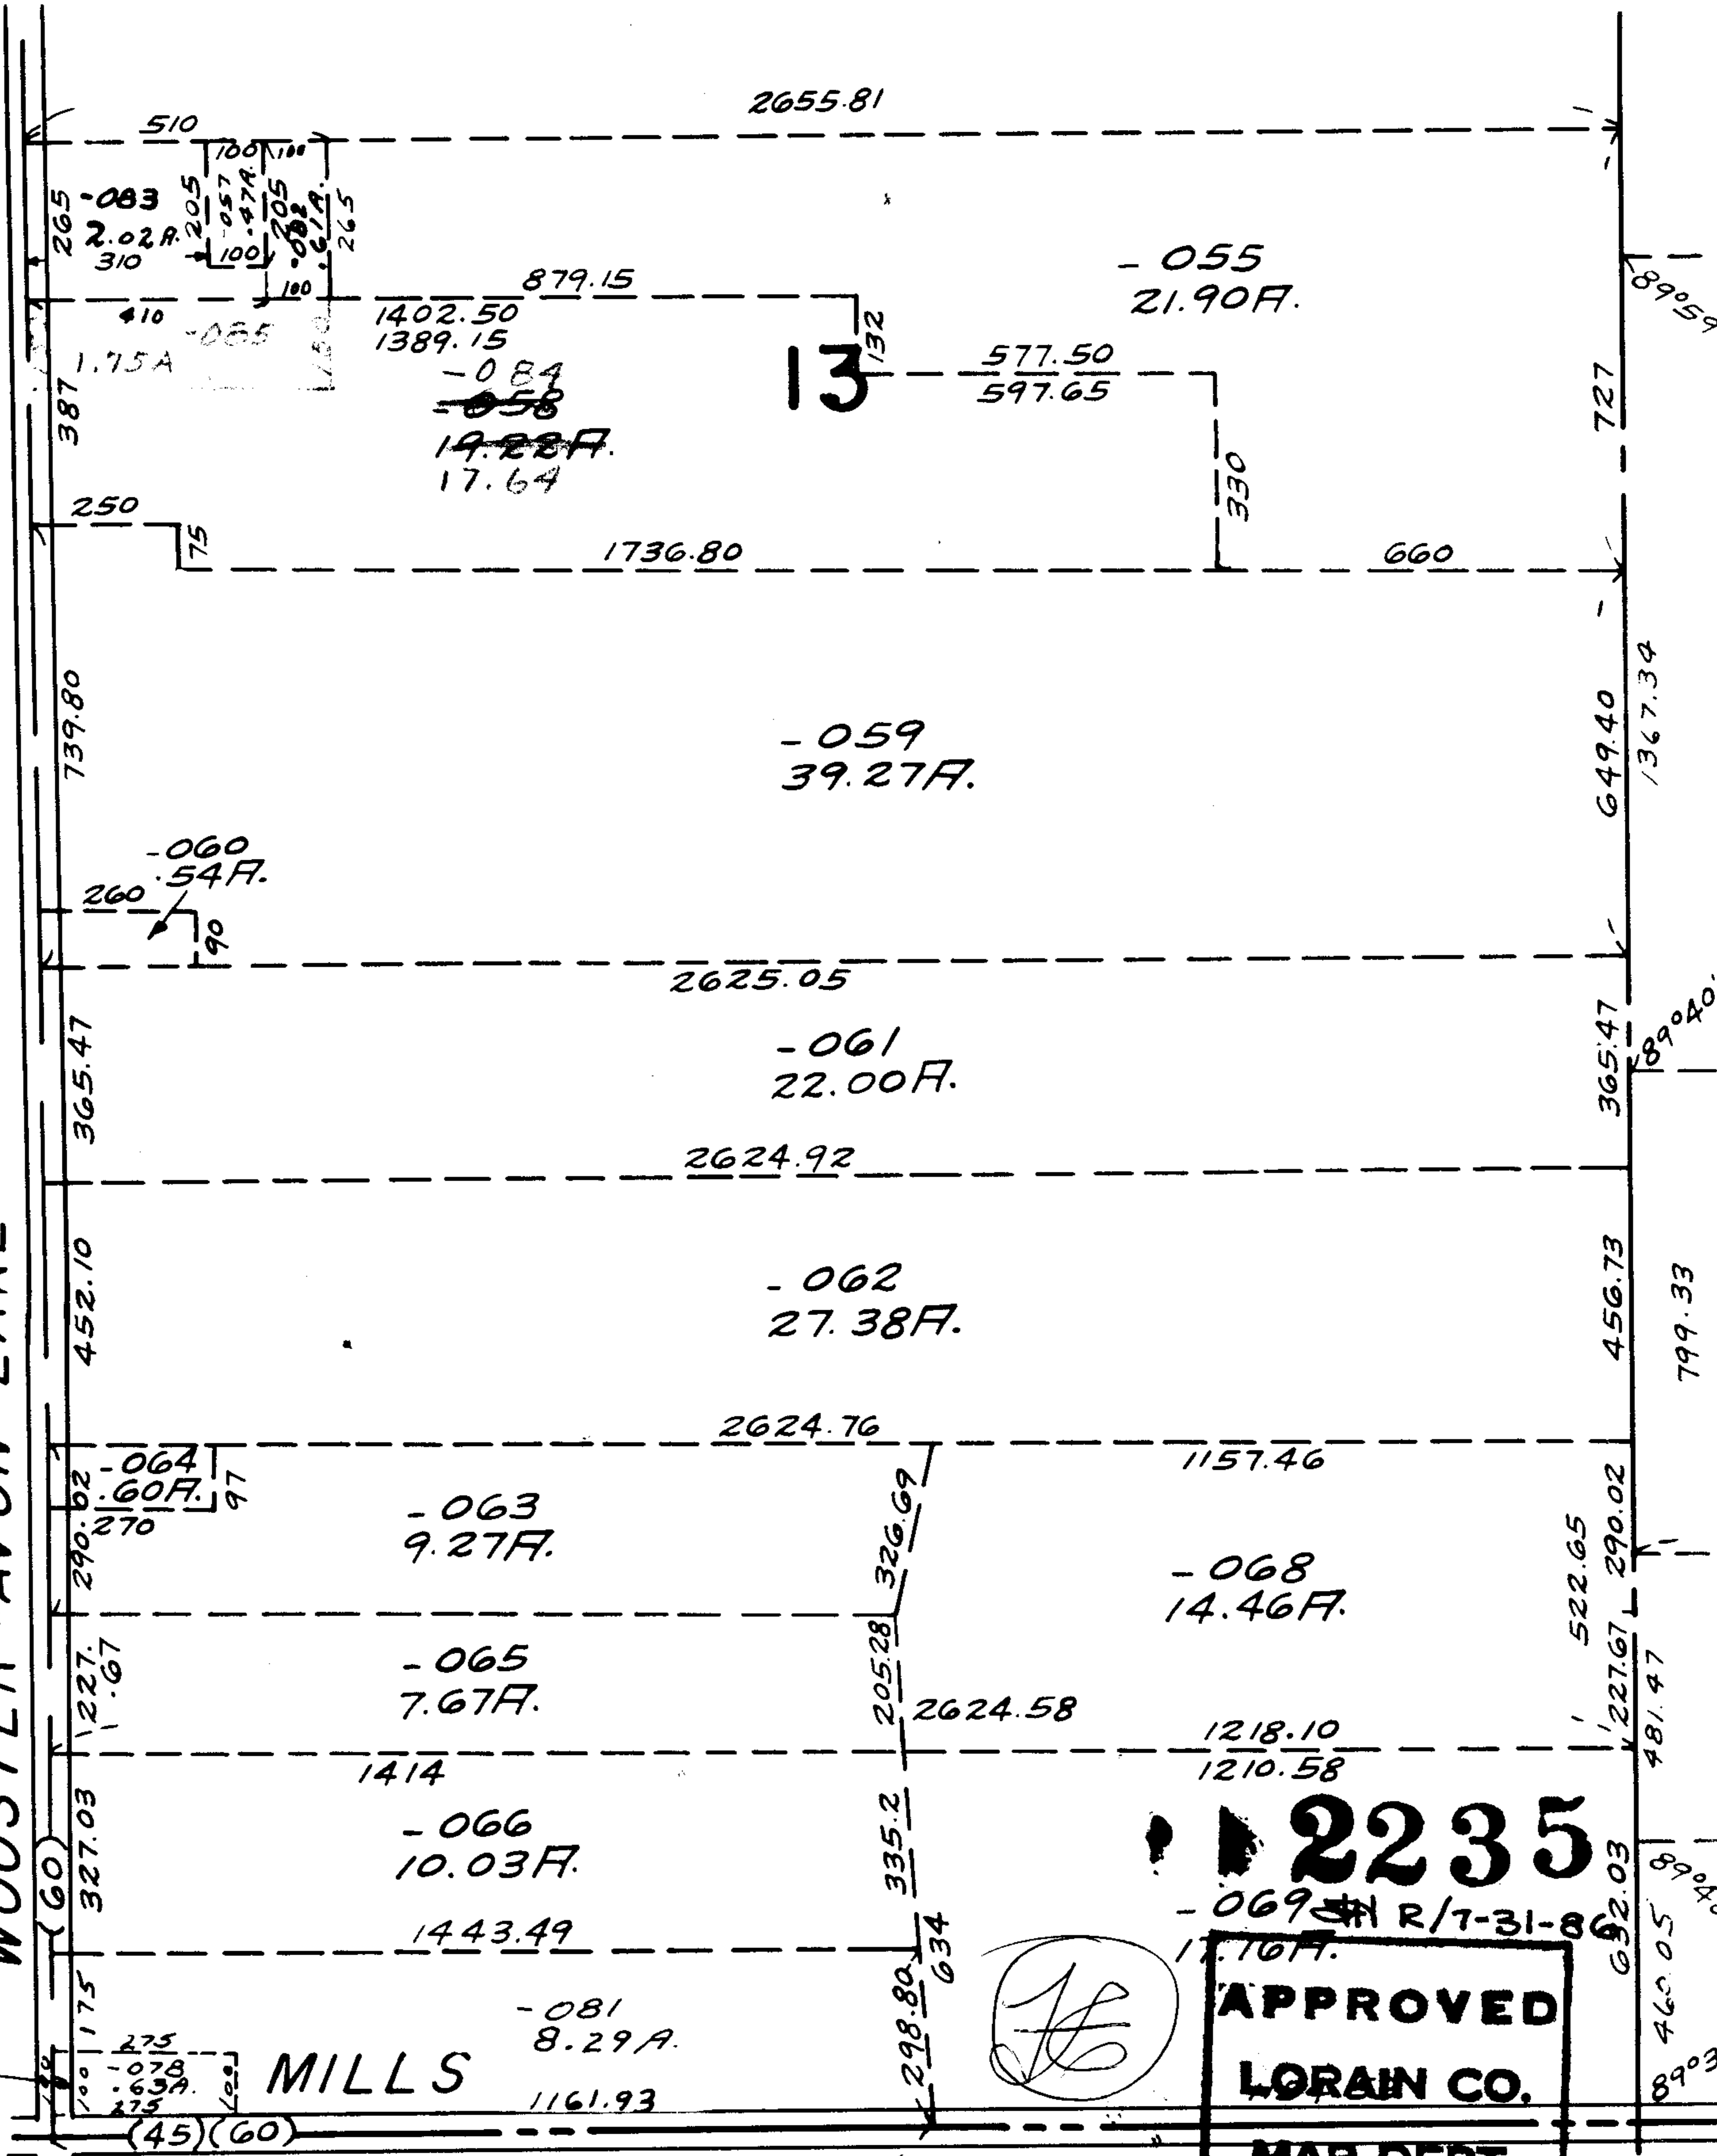

2235

R/7-31-86

APPROVED

LORAIN CO.

MAP DEPT.

DATE 11/12/68

Pg. 4-K

BY R. J. Kellum

Copyright 1963
REV. 4-10-68

4-K

AVON VILLAGE

SCALE: 1" = 400'