

102.02  
 - 60.00  
 42.02  
 + 5.88  
 47.90  
 21.10  
 69.00


#22350-D



COMBINED DEED FILED  
 FOR -001 AS IT  
 HAD 2 PARCELS ON  
 PRIOR DEED & ONLY 1  
 P.P. NO. PARCEL 1 & 2  
 WERE RESULT OF RAYBLUS  
 SURVEY

SEE DV 955 Pj. 471  
 FILE NO.  
 970501348  
 FILED 11/18/97

141

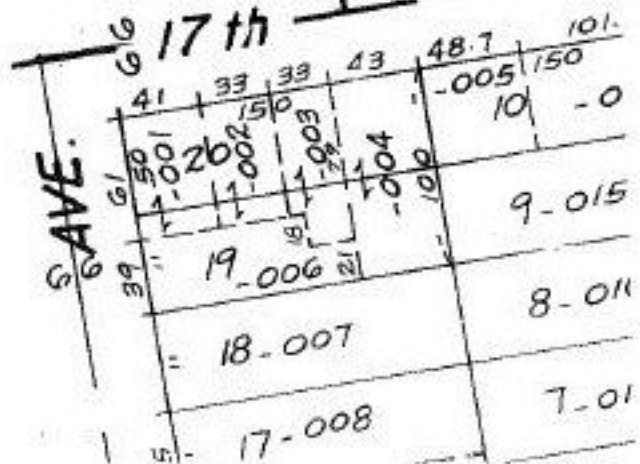

#22350-D

APPROVED	
LOTAB CO.	
RECORD	
DATE 11-18-97	
PAGE 2 of 003-F	
BY K. L. ... T.A.H.	
VOID	22350-D
AFTER	