


#22354  
NO. 22354

PARENT PARCEL: 05-00-017-000-098, 099  
CHILD PARCEL: 05-00-017-000-157, 158, 159  
STARTING POINT: South line of Milan Ave. & west line of Crocker St.

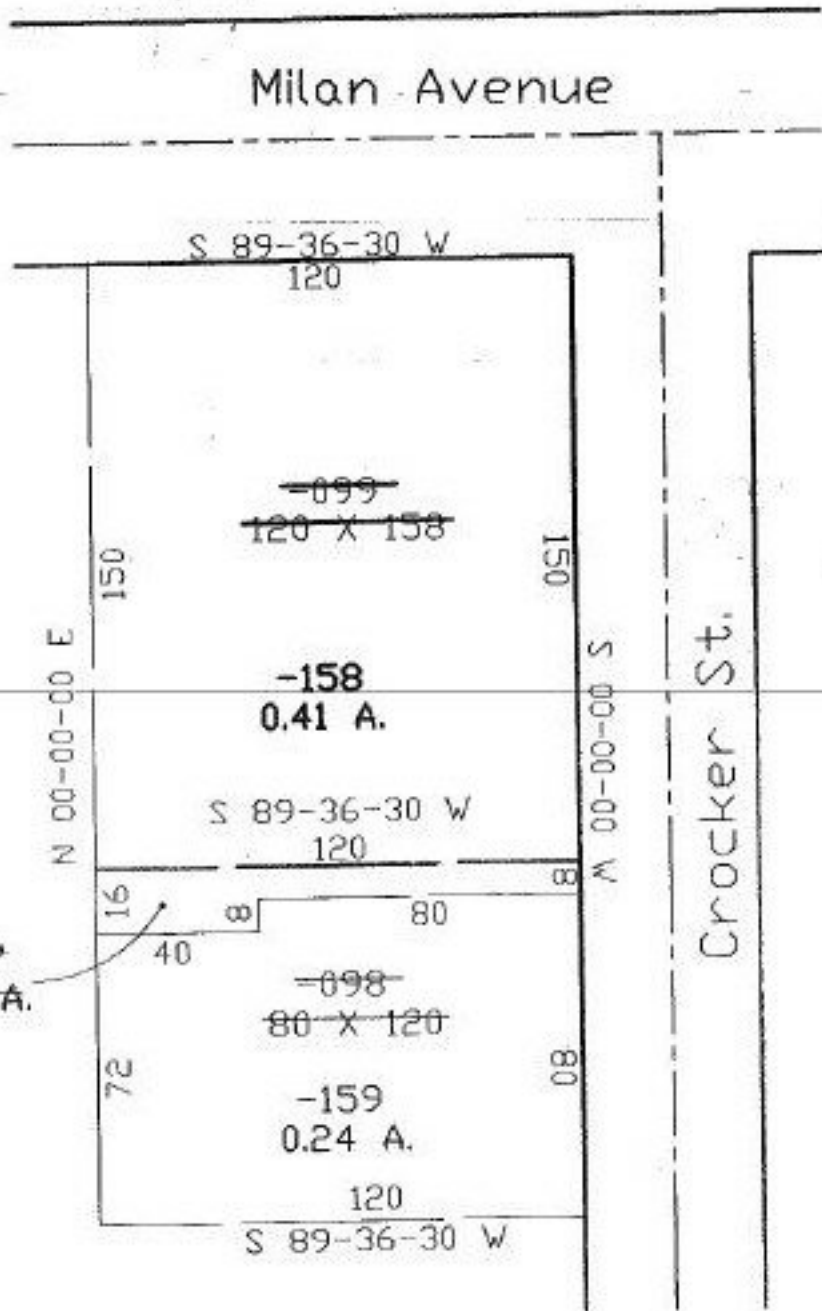

**SPLITS/DEEDS PROCESSED**  
LORAIN COUNTY TAX MAP DEPARTMENT  
226 MIDDLE AVE. ELYRIA, OHIO

SURVEYED BY: Charles P. Woryu  
CLOSURE: 0.84 A.  
MAP PAGE(S): 05-00-017-8 DATE: 11/11/97  
APPROVED BY: kac SCALE: 1" = 50'  
PRIOR INSTRUMENT: OR 46/738 & OR 352/679