

#22357

NO. 22357

PARENT PARCEL: 04-00-016-101-065

CHILD PARCEL: 04-00-016-101-074, 075


STARTING POINT: cl. of Norfolk & Southern R.R. & cl. of Avon Belden Rd.



D.L. 17 CL NORFOLK & SOUTHERN R.R.

D.L. 16

Avon Belden Rd. (S.R. 83)

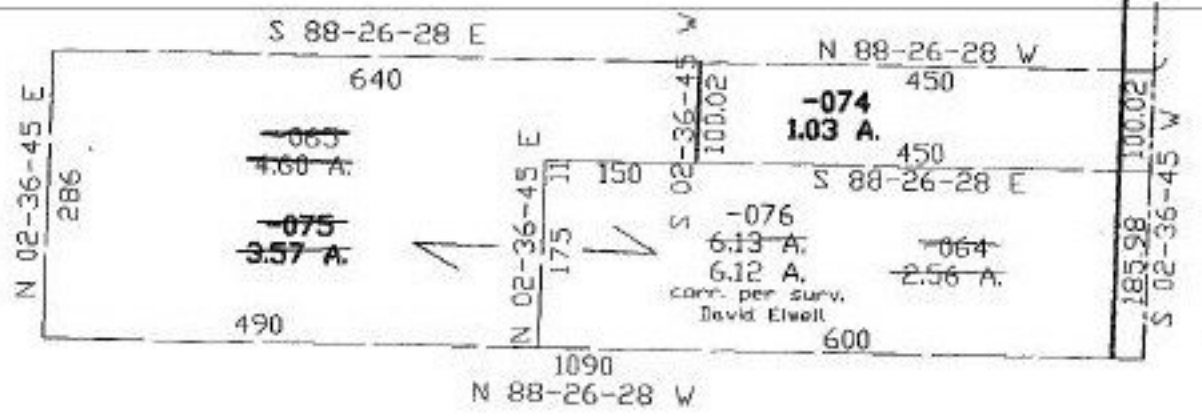

SPLITS/DEEDS PROCESSED
 LORAIN COUNTY TAX MAP DEPARTMENT
 226 MIDDLE AVE. ELYRIA, OHIO

SURVEYED BY: David L. Elwell
 CLOSURE: 0.00:10.000
 MAP PAGE(S): 04-00-016-B
 APPROVED BY: kac DATE: 11/21/97
 SCALE: 1" = 200' PRIOR INSTRUMENT: 1088/190.1354/265