


#22361-A

SEE 11-00-055-B

83

1362.24
AVON LAKE
100

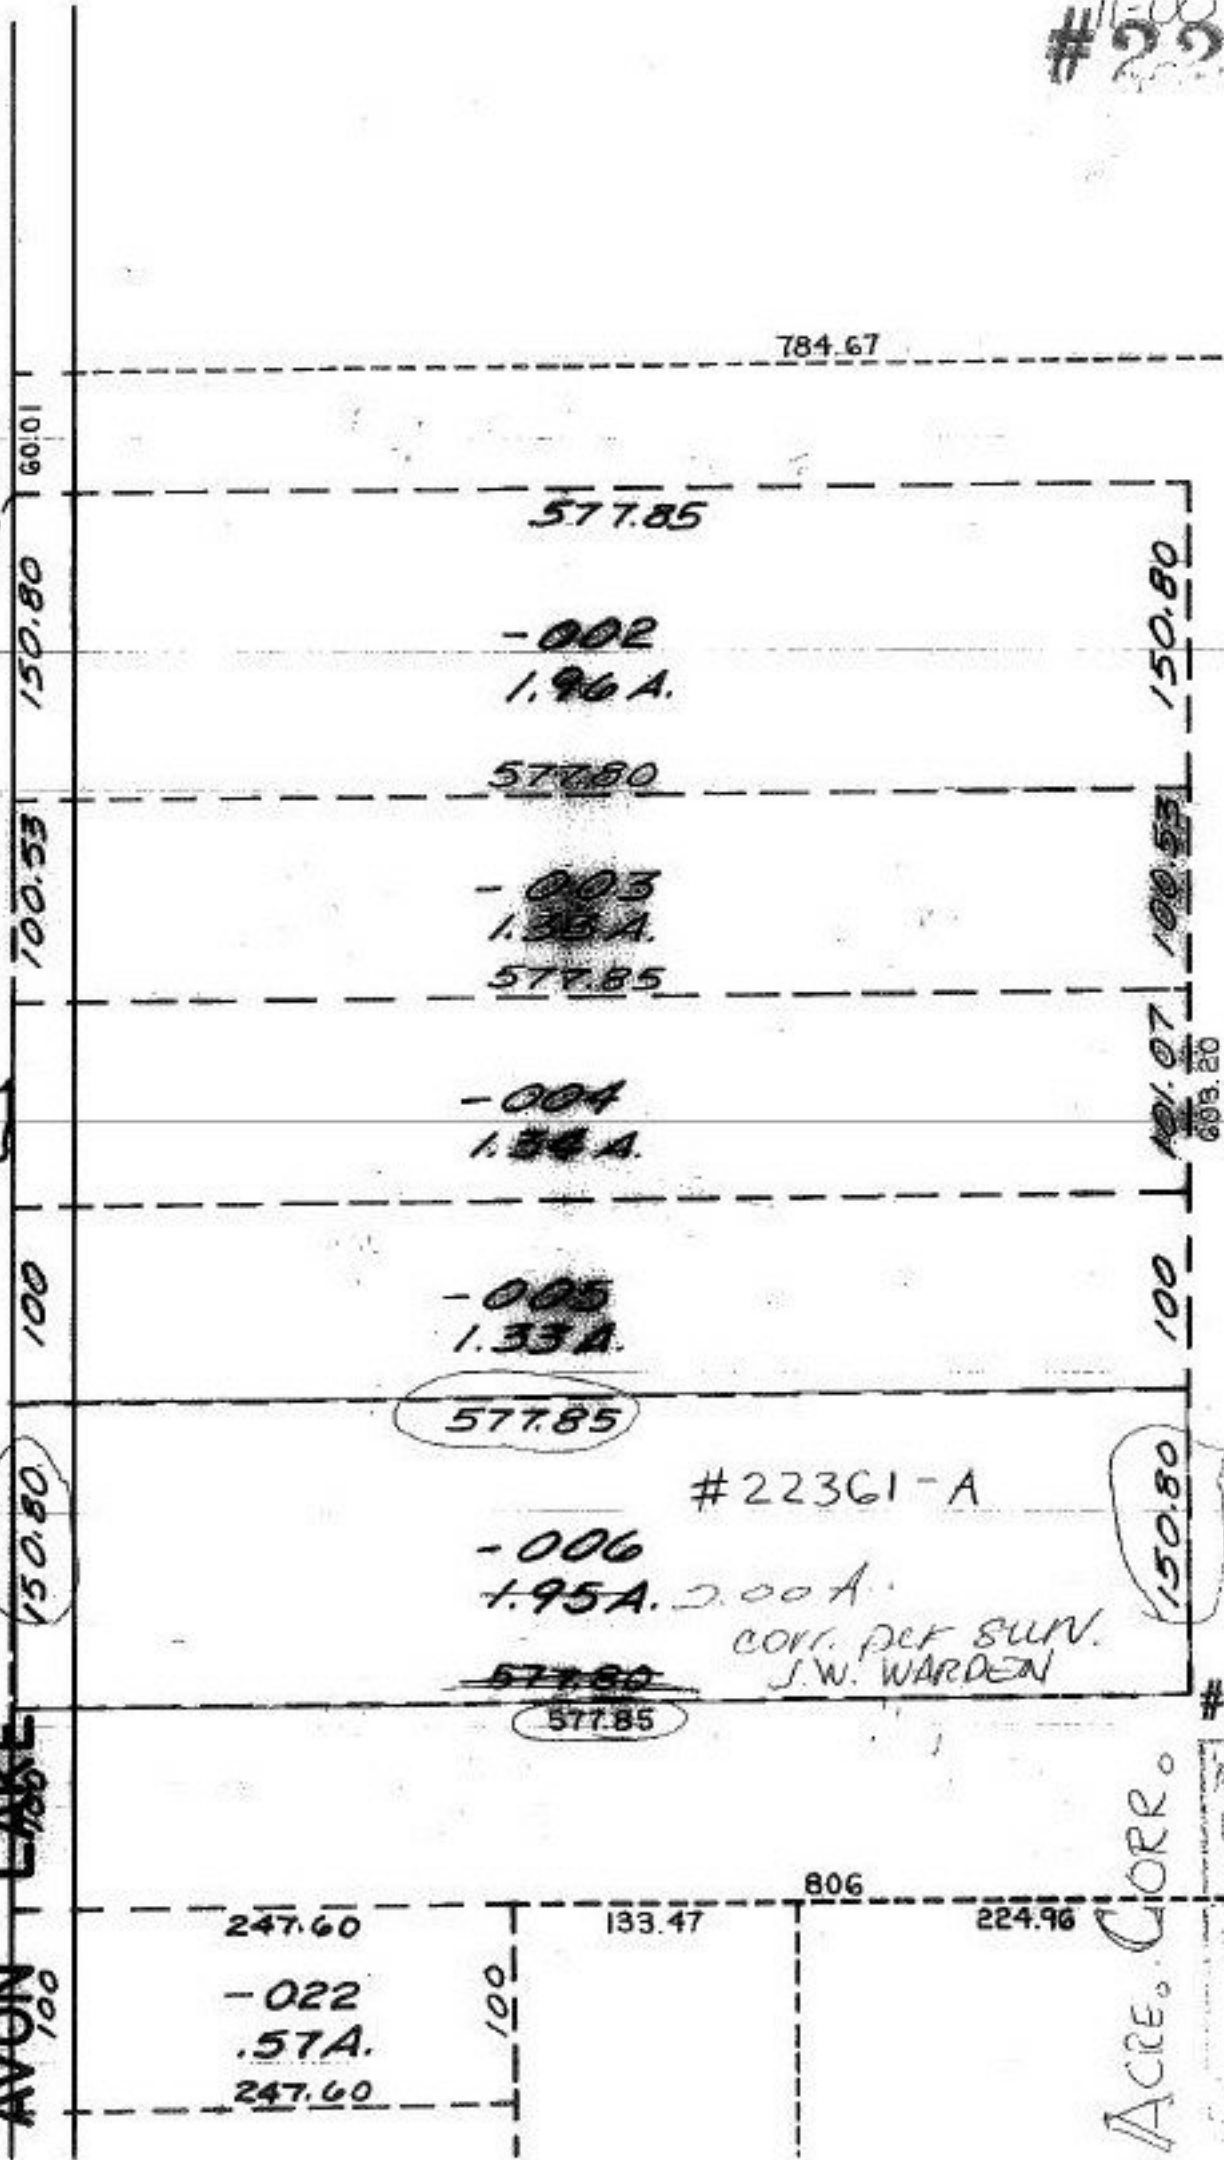

#22361-A

#22361-A

APPROVED
LORAIN CO.
MAP DEPT.

12/21/97
11-00-046-1
K. Collier
22361-A

ACCE. CORR.