


PT. 05-00-033-000-004
PT. 25.40 A.



#22361

APPROVED	
LORAIN CO.	
MAP DEPT.	
DATE 11-24-97	
PAGE 5-00-032-A	
BY <i>[Signature]</i>	
NO. 22361	ADPR

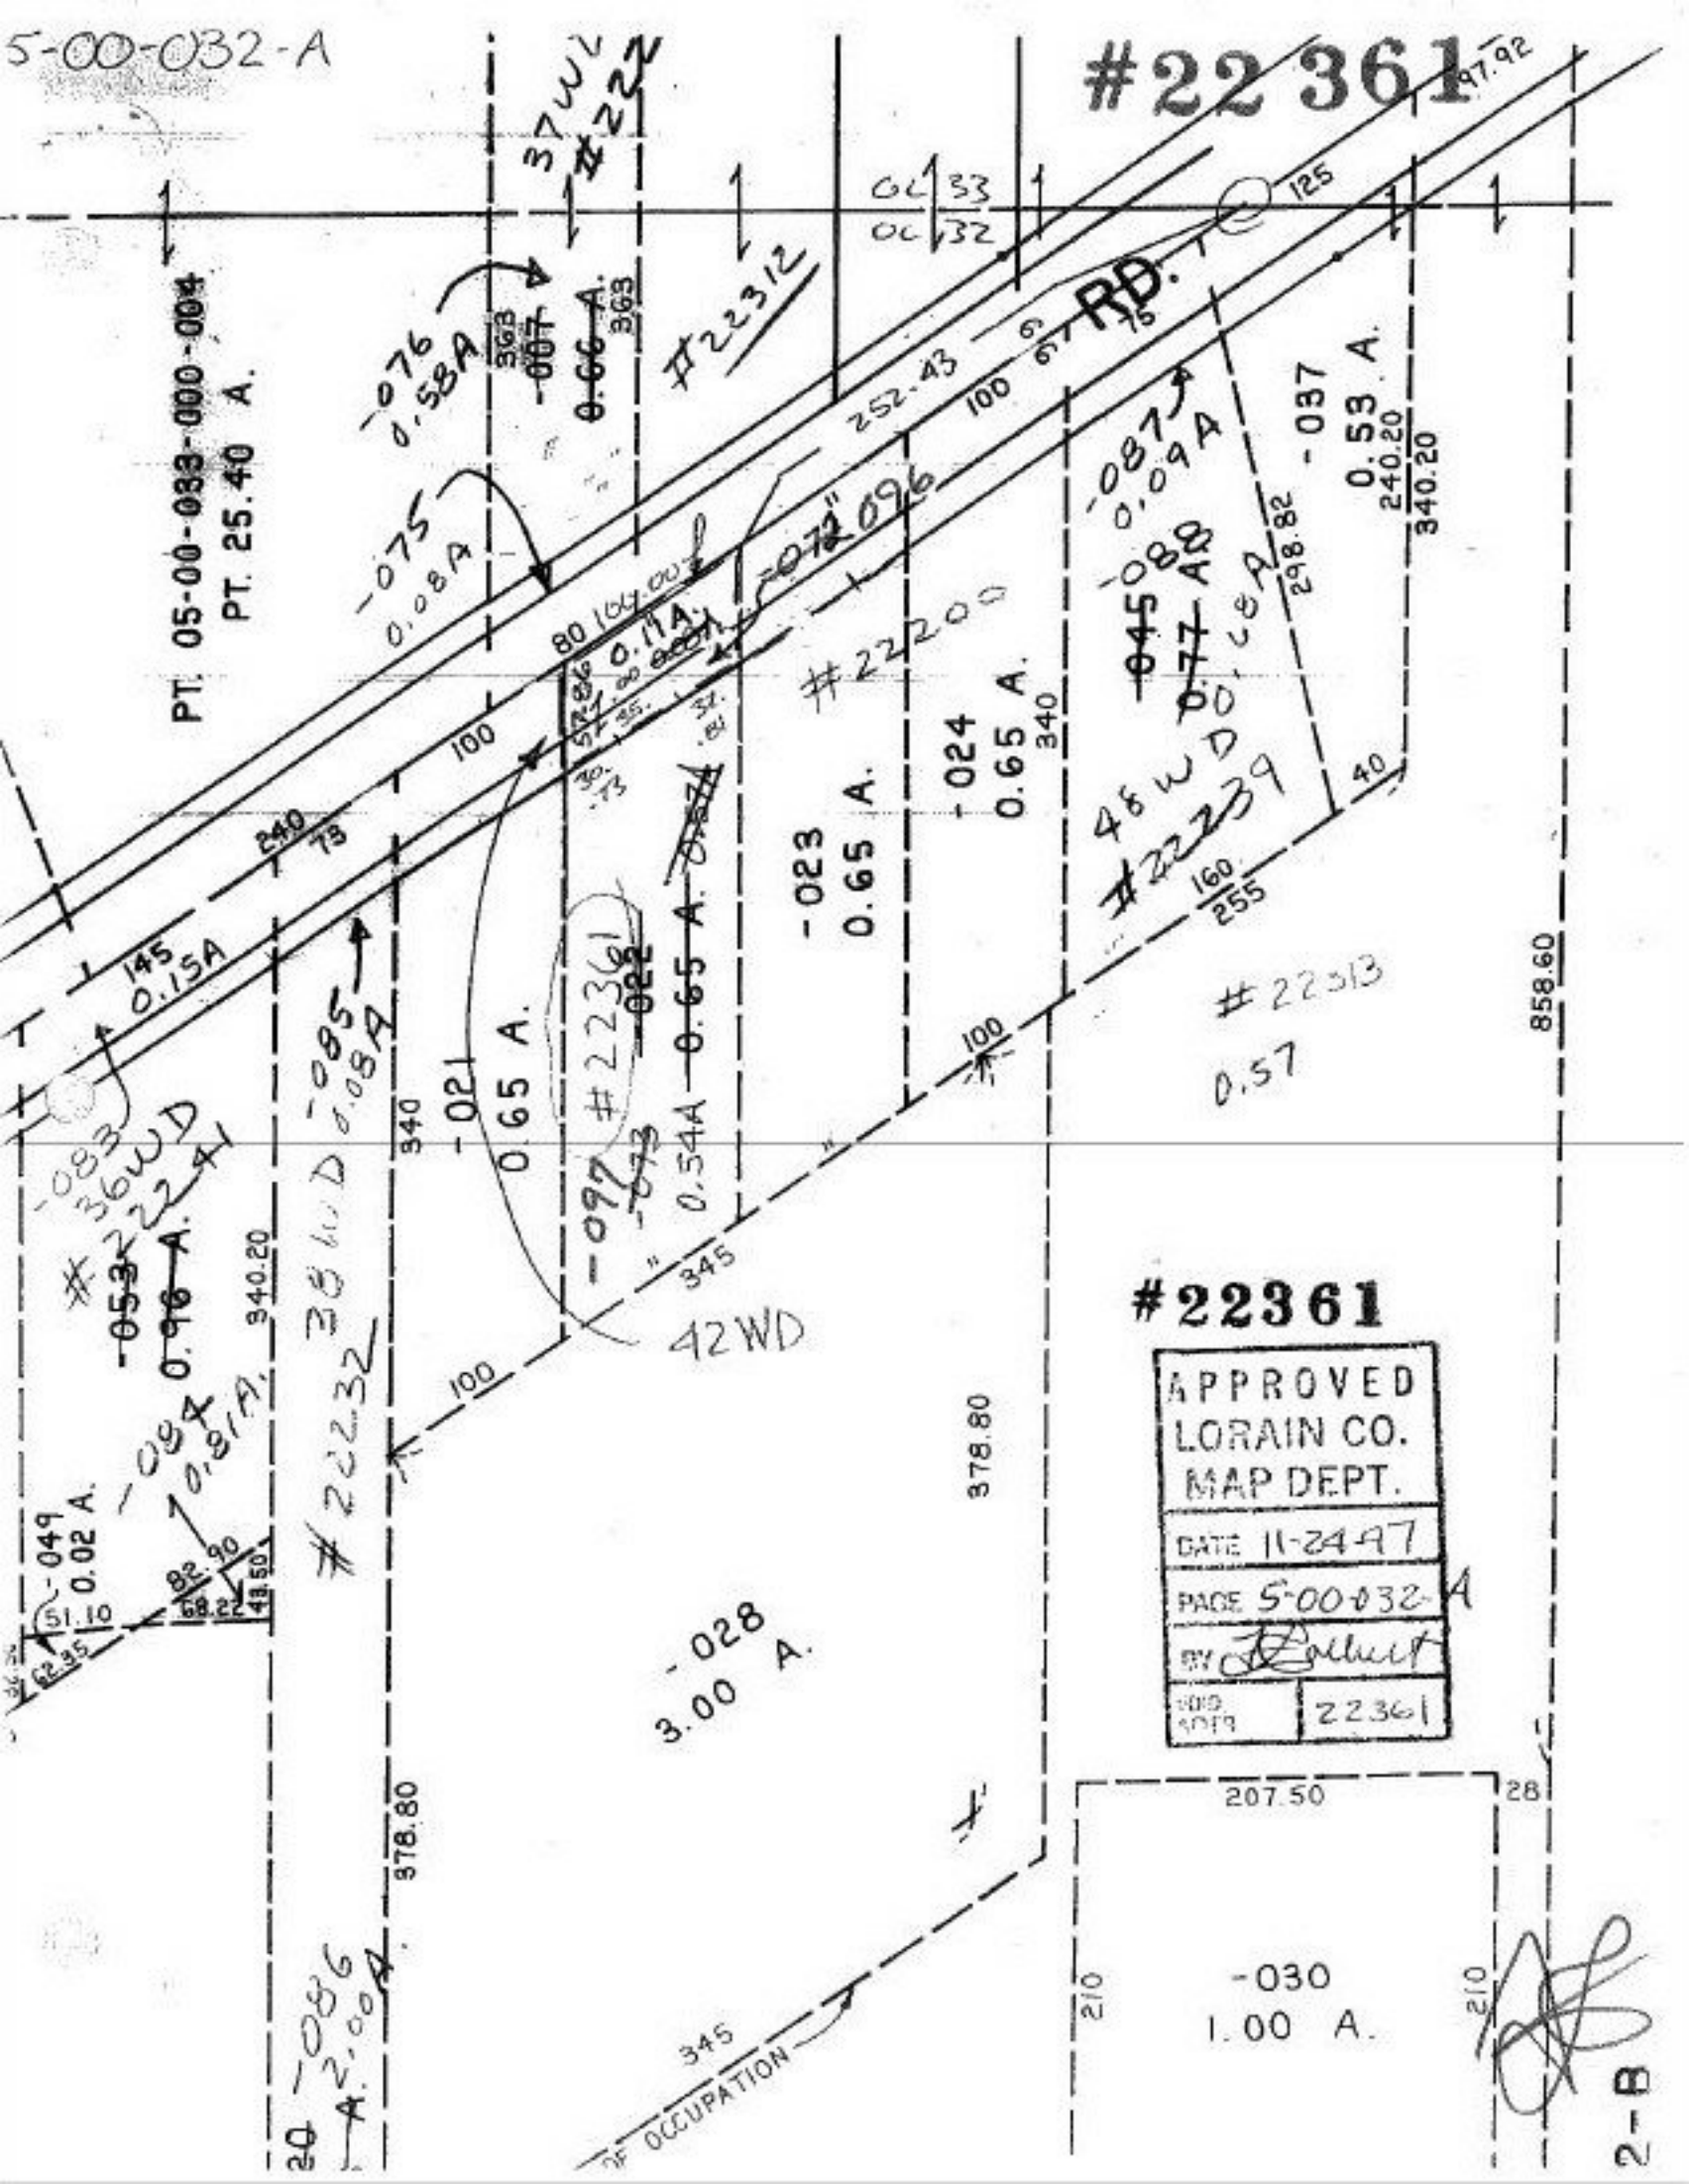