

#22364A

1465.85  
-003 0 A. 1462.35  
-004 1.00 A. 1458.85

-005  
7.25 A.

1457.6

-006  
3.28 A.

1430.24

-007  
4.00 A.

1421.70

-008  
5.00 A.


1409.08

-009  
4.00 A.

1400.4

-010  
4.00 A.

1391.04

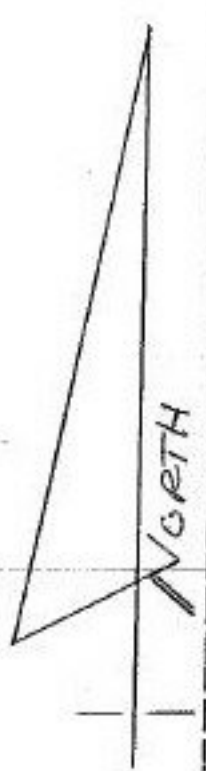

#22364-A

APPROVED  
LORAIN CO.  
MAP DEPT.  
DATE 12-11-97  
PAGE 5-00-068-A  
BY K. Colbert

#22364-A

APPROVED  
LORAIN CO.  
MAP DEPT.  
DATE 12-11-97  
PAGE 5-00-068-A  
BY K. Colbert

FRONTAGE CORR. PER  
CHARLES R. WARYU #22364-A  
~SEE OR 92, P519~

125.42  
123.98

SEE 5-00-068-B

RD. 66 113