



PARENT PARCEL: 04-00-022-102-061

CHILD PARCEL: 04-00-022-102-066, 067, 068

STARTING POINT: c.l. of North Ridge Rd. & c.l. of Lear Nagle Rd.


NO. 22364

DETAIL

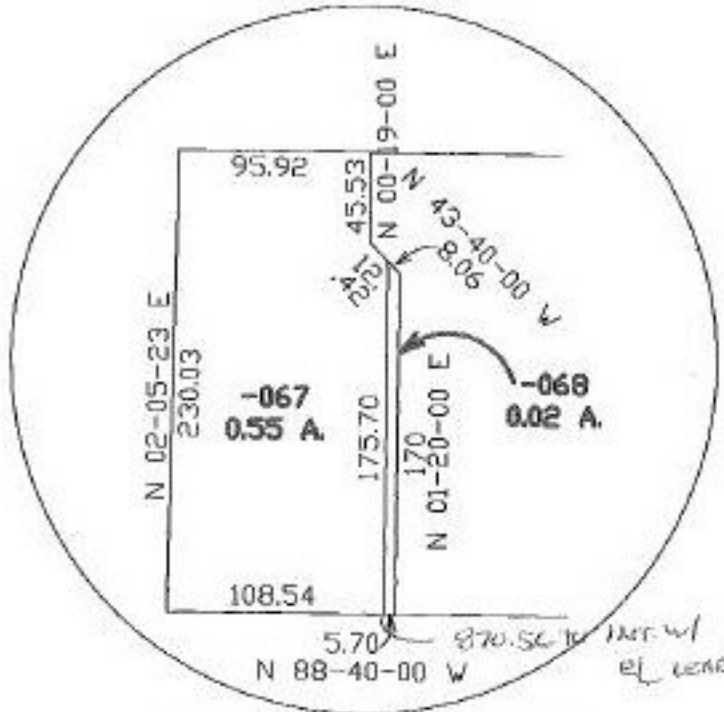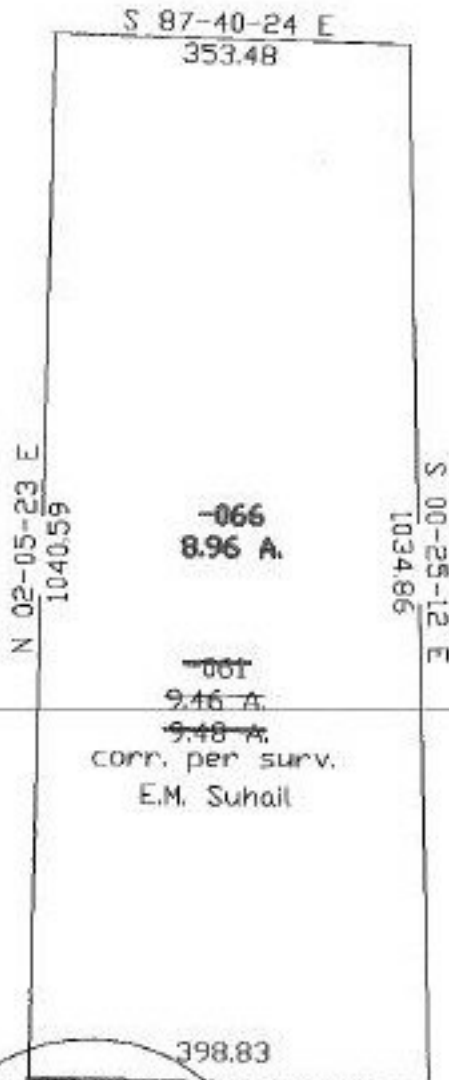

SCALE 1"=50'

SEE DETAIL

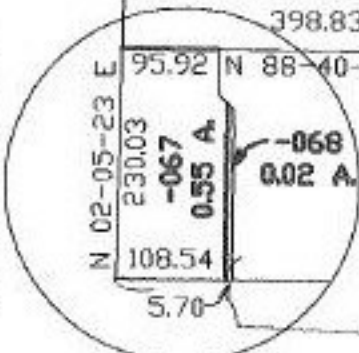

North Ridge Rd.

Lear Nagle Rd.



SPLITS/DEEDS PROCESSED
 LORAIN COUNTY TAX MAP DEPARTMENT
 226 MIDDLE AVE. ELYRIA, OHIO

SURVEYED BY: E.M. Suhail
 CLOSURE: 0.01:10.000
 MAP PAGE(S): 04-00-022-H
 APPROVED BY: koc DATE: 2/9/98
 SCALE: 1"=200. PRIOR INSTRUMENT: #970493249