

PARENT PARCEL: 04-00-011-107-076, 060, 089, 162, 163


CHILD PARCEL: 04-00-011-107-166 thru -171

STARTING POINT: cl. of Detroit Rd. & cl. of Long Rd.

NO. 22365



Detroit Rd.

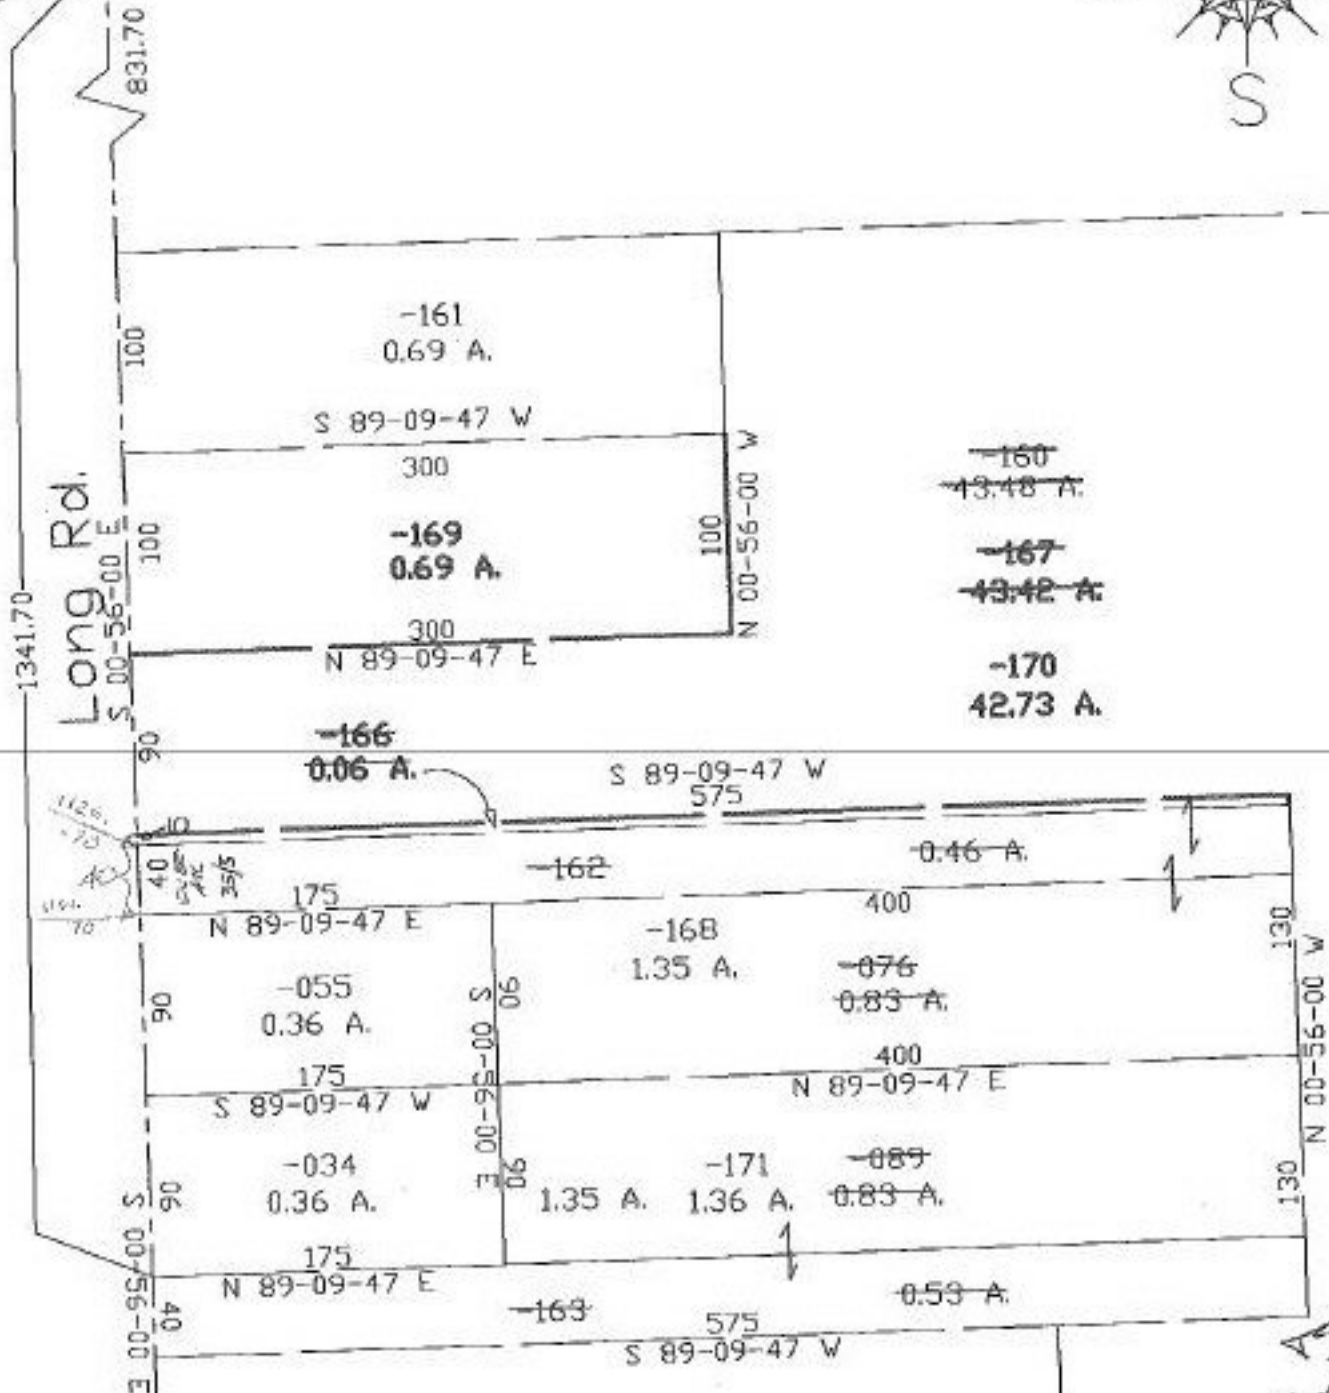

AS
2-4-99



SPLITS/DEEDS PROCESSED
 LORAIN COUNTY TAX MAP DEPARTMENT
 228 MIDDLE AVE. ELYRIA, OHIO

SURVEYED BY: Vincent McGarvey
 CLOSURE:
 MAP PAGE(S): 04-00-011-E DATE: 12/11/97
 APPROVED BY: kac SCALE: 1" = 100
 PRIOR INSTRUMENT: OR 969/56 OR 1163/743