


#22367

PARENT PARCEL: 12-00-088-000-002  
CHILD PARCEL: 12-00-088-000-076, 077  
STARTING POINT: cl. of Capel Rd. & cl. of Station Rd.

NO. 22367

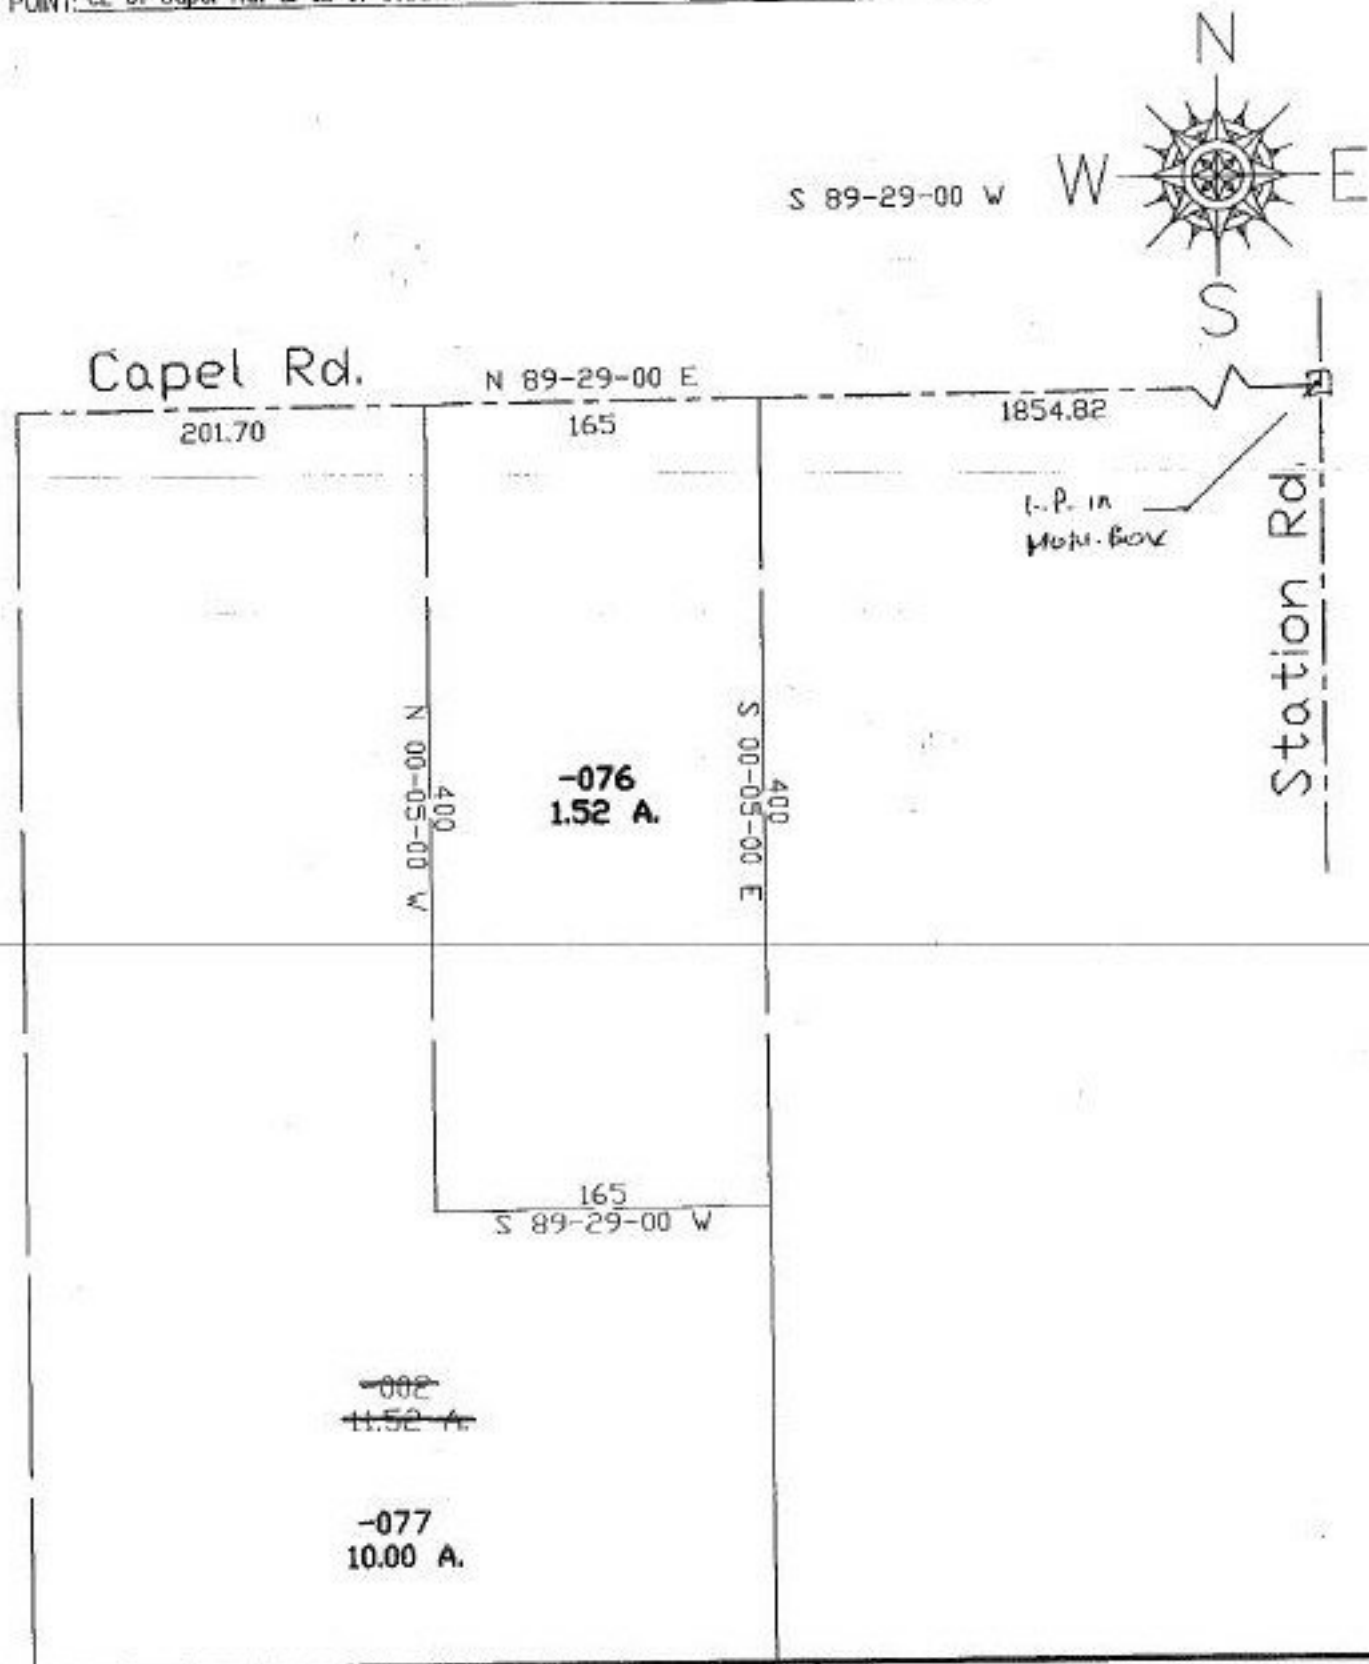

**SPLITS/DEEDS PROCESSED**  
 LORAIN COUNTY TAX MAP DEPARTMENT  
 226 MIDDLE AVE. ELYRIA, OHIO

SURVEYED BY: John Pozymak  
 CLOSURE: 0.00:10.000  
 MAP PAGE(S): 12-00-088-A  
 APPROVED BY: kac DATE: 12/11/97  
 SCALE: 1" = 100' PRIOR INSTRUMENT: #970475467