


PARENT PARCEL: 07-00-038-000-116
 CHILD PARCEL: 07-00-038-000-124, 125
 STARTING POINT: cl. of Sugar Ridge Rd. & W. line of O.L. 38


NO. 22369

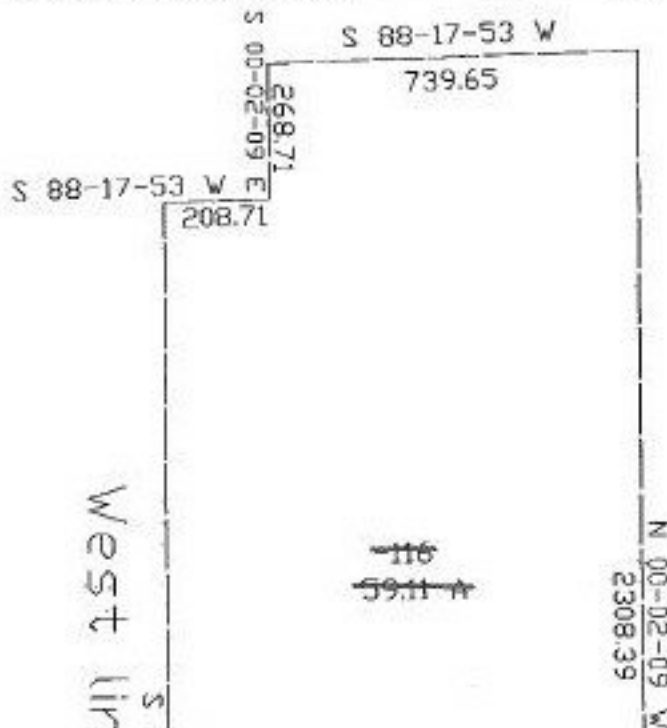

-116
59.11
-124
52.34 A.

corr. per surv.
Dane Haponek

I.P.C. INTERSECT.
OL 38 & CE
OF SUGAR RIDGE RD.

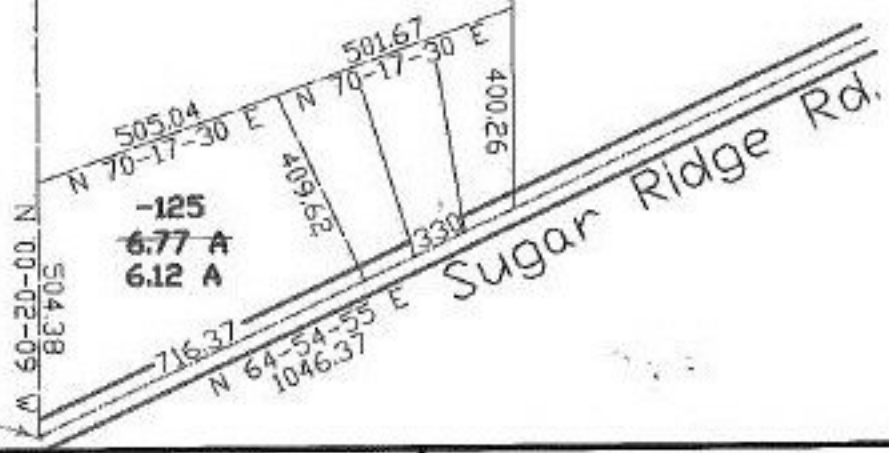

Sugar Ridge Rd.

SURVEYED BY: Dane A. Haponek
 CLOSURE: 0.01:10.000
 MAP PAGE(S): 7-E
 APPROVED BY: kac DATE: 12/12/97
 SCALE: 1" = 400' PRIOR INSTRUMENT: #970500111



SPLITS/DEEDS PROCESSED
 LORAIN COUNTY TAX MAP DEPARTMENT
 226 MIDDLE AVE. ELYRIA, OHIO