
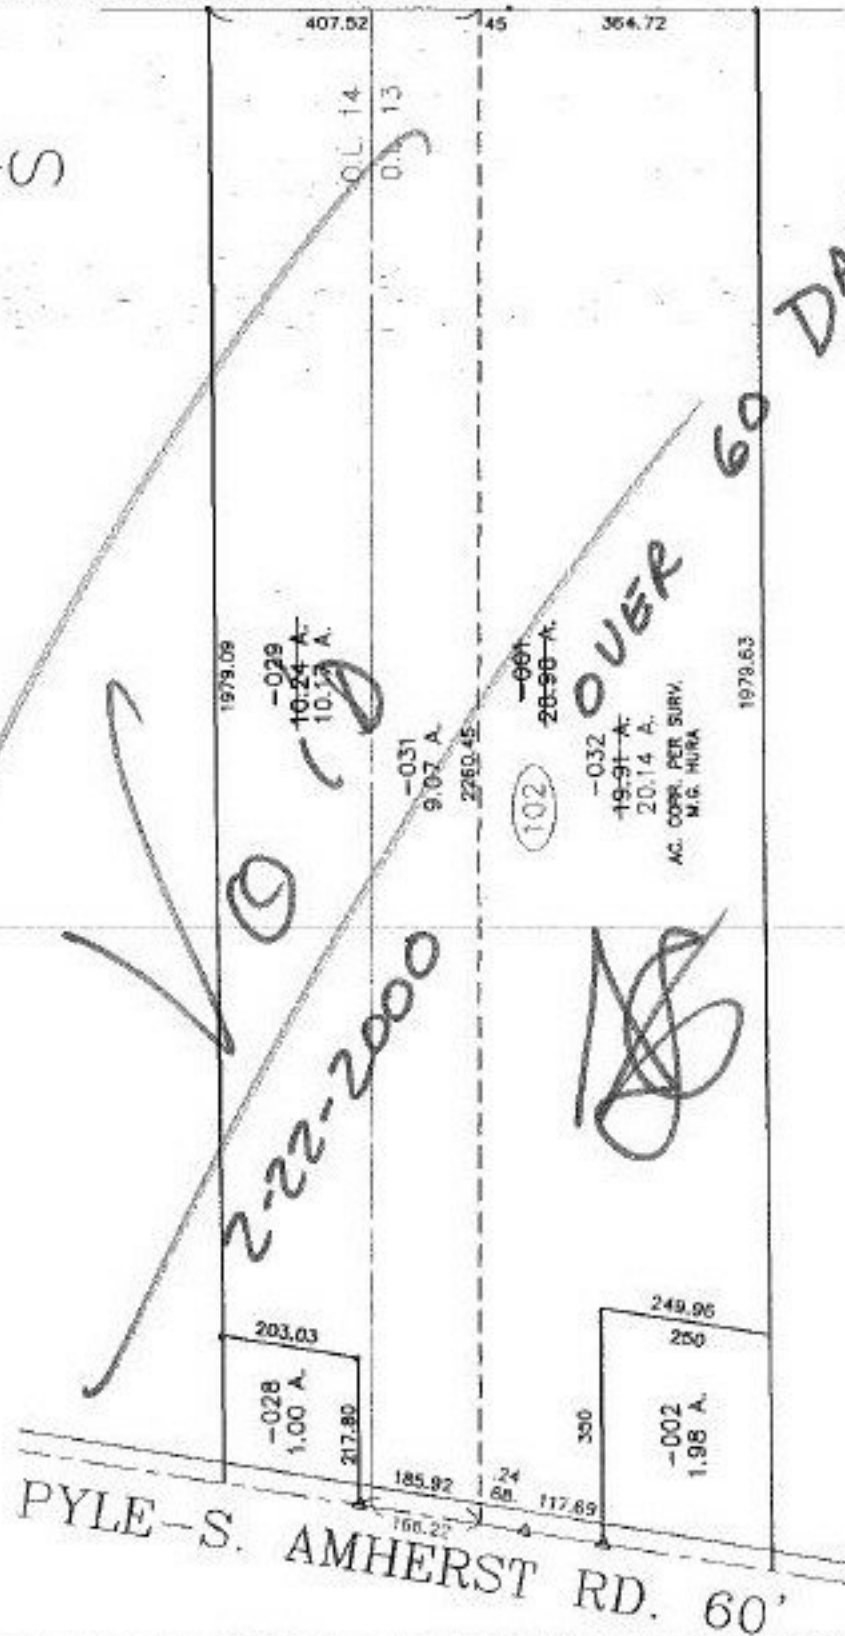


PARENT PARCEL: 05-00-013-102-001

CHILD PARCEL: 05-00-013-102-031 & -032

STARTING POINT: CL OF PYLE-S. AMHERST RD. & NORTH LINE OF O.L. 13

NO. 22370

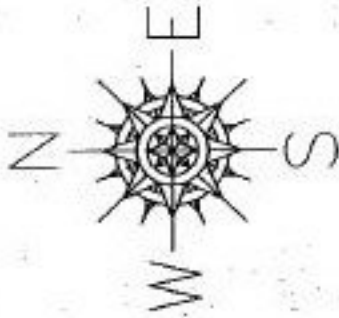

SPLITS/DEEDS PROCESSED
 LORAIN COUNTY TAX MAP DEPARTMENT
 226 MIDDLE AVE. ELYRIA, OHIO

SURVEYED BY: M.G. HURA
 CLOSURE: 0.06 : 10,000
 MAP PAGE(S): 05-00-013-A&B, 05-00-014-A&B
 APPROVED BY: I. SPILLMAN DATE: 12/08/99
 SCALE: 1" = 300' PRIOR INSTRUMENT: OR 1319/241

A.M.