

#22373


NO. 22373

PARENT PARCEL: 05-00-057-000-248  
CHILD PARCEL: 05-00-057-000-253 thru 256  
STARTING POINT: South line of O.L. 57 and c.L. of Old Middle Ridge Rd.



~~pt. 248~~  
~~pt. 31.87 A.~~  
pt. -256  
pt. 30.91 A.

Old Middle Ridge Rd.

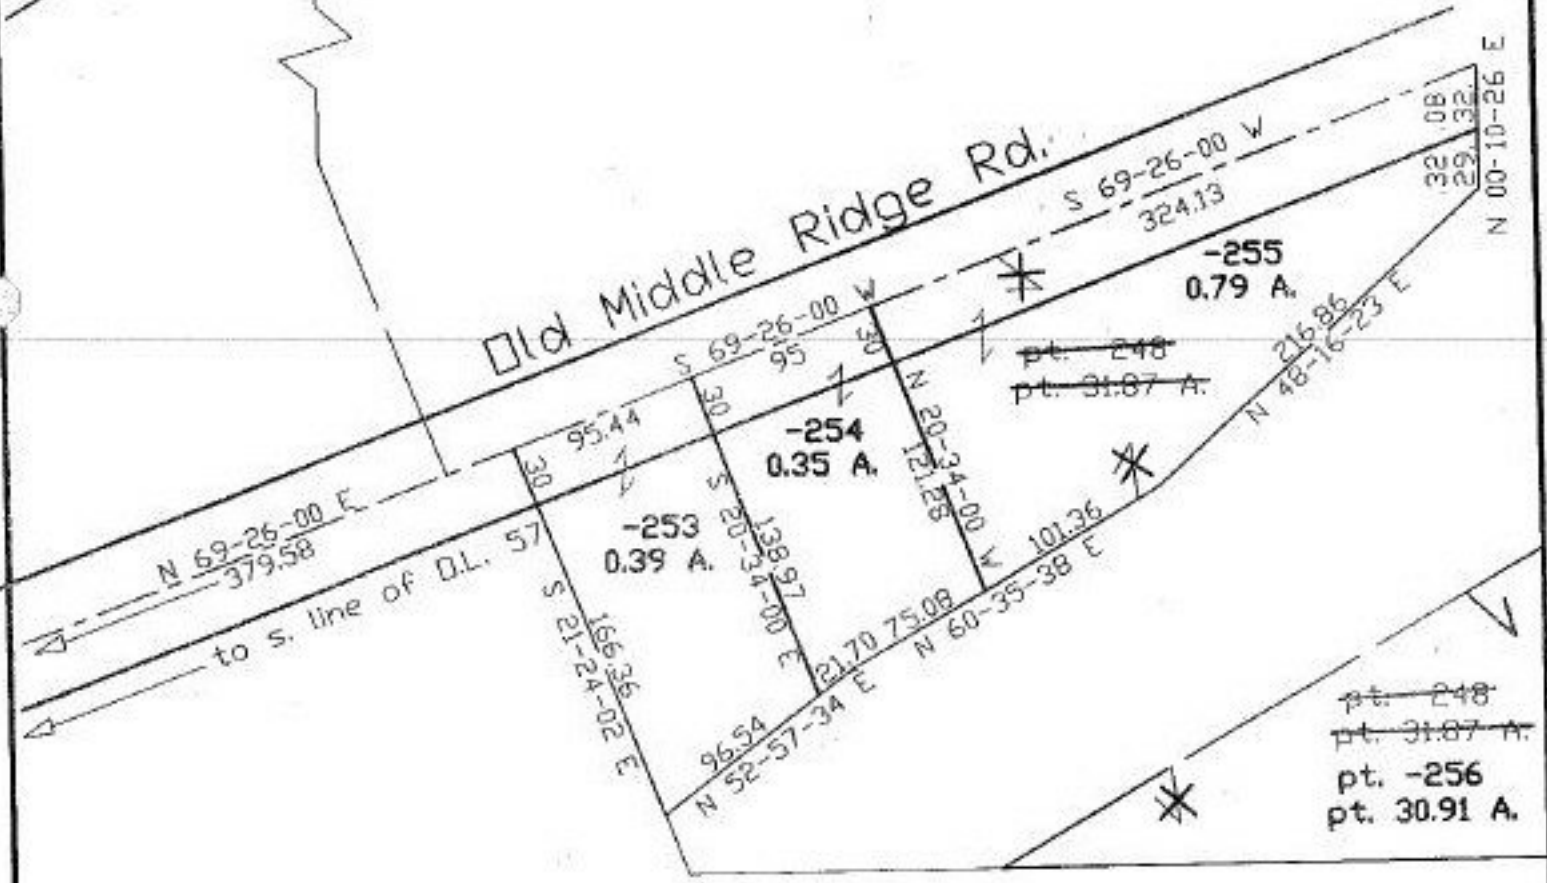

**SPLITS/DEEDS PROCESSED**  
LORAIN COUNTY TAX MAP DEPARTMENT  
226 MIDDLE AVE. ELYRIA, OHIO

SURVEYED BY: Patrick A. McGannon  
CLOSURE: 0.16:10,000  
MAP PAGE(S): 05-00-057-A  
APPROVED BY: kac DATE: 12/2/97  
SCALE: 1" = 100' PRIOR INSTRUMENT: