

PARENT PARCEL: 02-03-00-007-000-089

CHILD PARCEL: 02-03-007-000-093 thru 096

STARTING POINT: cl. of Oak Tree Drive South & cl. of Oak Tree Drive North


#22375
NO. 22375



Oak Tree Drive North

Oak Tree Drive South
PV 59/23

Oak Tree Drive North
PV 57/50

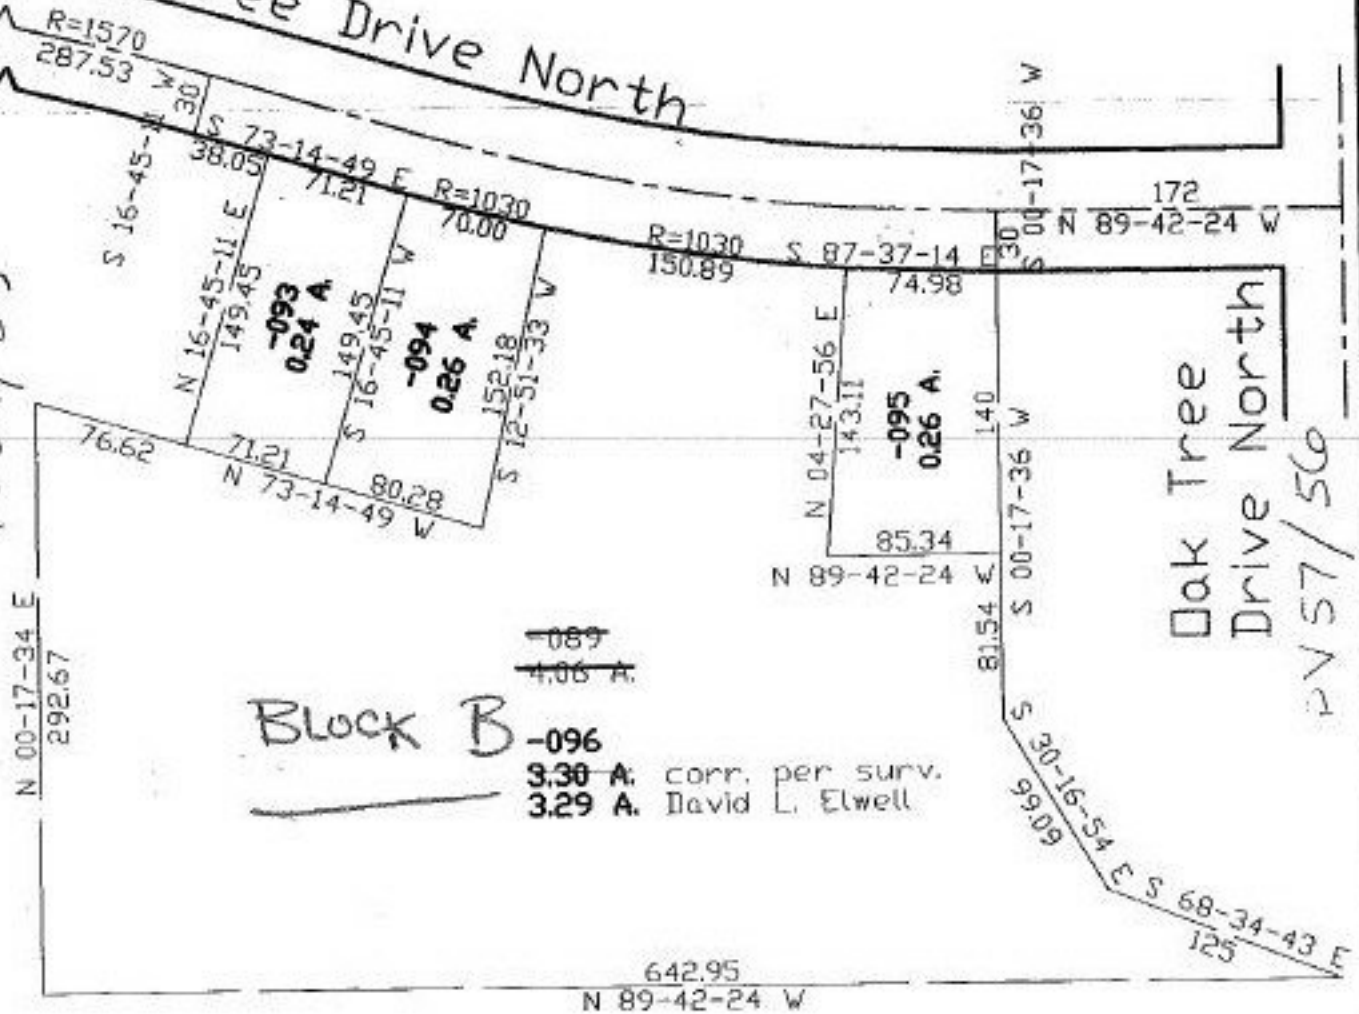

Block B

~~089~~
4.06 A.

~~096~~
3.30 A. corr. per surv.
3.29 A. David L. Elwell



SPLITS/DEEDS PROCESSED
LORAIN COUNTY TAX MAP DEPARTMENT
228 MIDDLE AVE. ELYRIA, OHIO

SURVEYED BY: David L. Elwell
CLOSURE: 0.09:10.000
MAP PAGE(S): 2-E
APPROVED BY: kgc DATE: 12/16/97
SCALE: 1" = 100' PRIOR INSTRUMENT: Plat 59/22-23