


#22379

NO. 22379

PARENT PARCEL: 05-00-006-000-083  
CHILD PARCEL: 05-00-006-000-084, -085  
STARTING POINT: c.l. of South Lake Street & n. line of O.L. 6

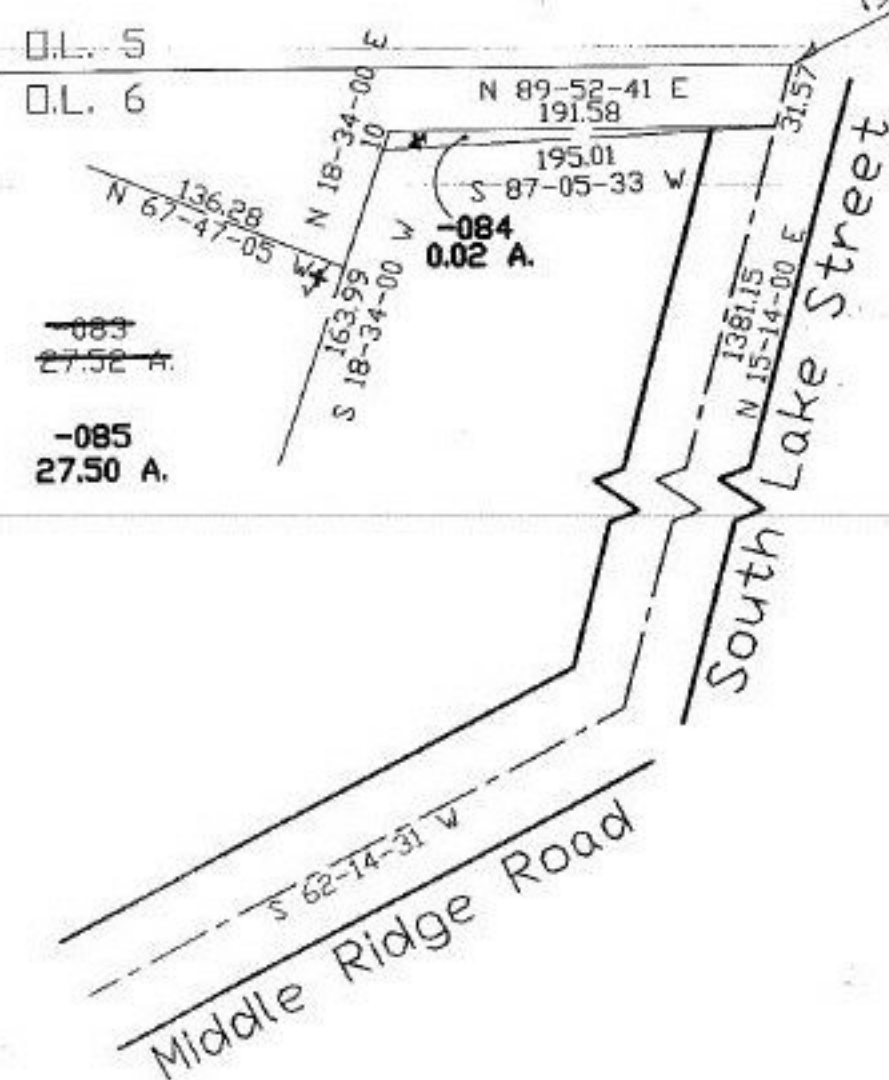

1381.15 S. of the  
N. LINE of O.L. 6

South Lake Street

Middle Ridge Road



**SPLITS/DEEDS PROCESSED**  
LORAIN COUNTY TAX MAP DEPARTMENT  
226 MIDDLE AVE. ELYRIA, OHIO

SURVEYED BY: Philip A. Rosebeck  
CLOSURE: 0.16:10,000  
MAP PAGE(S): 05-00-006-A  
APPROVED BY: kac DATE: 12/19/97  
SCALE: 1" = 100' PRIOR INSTRUMENT: OR 1265/741