


#22381-X

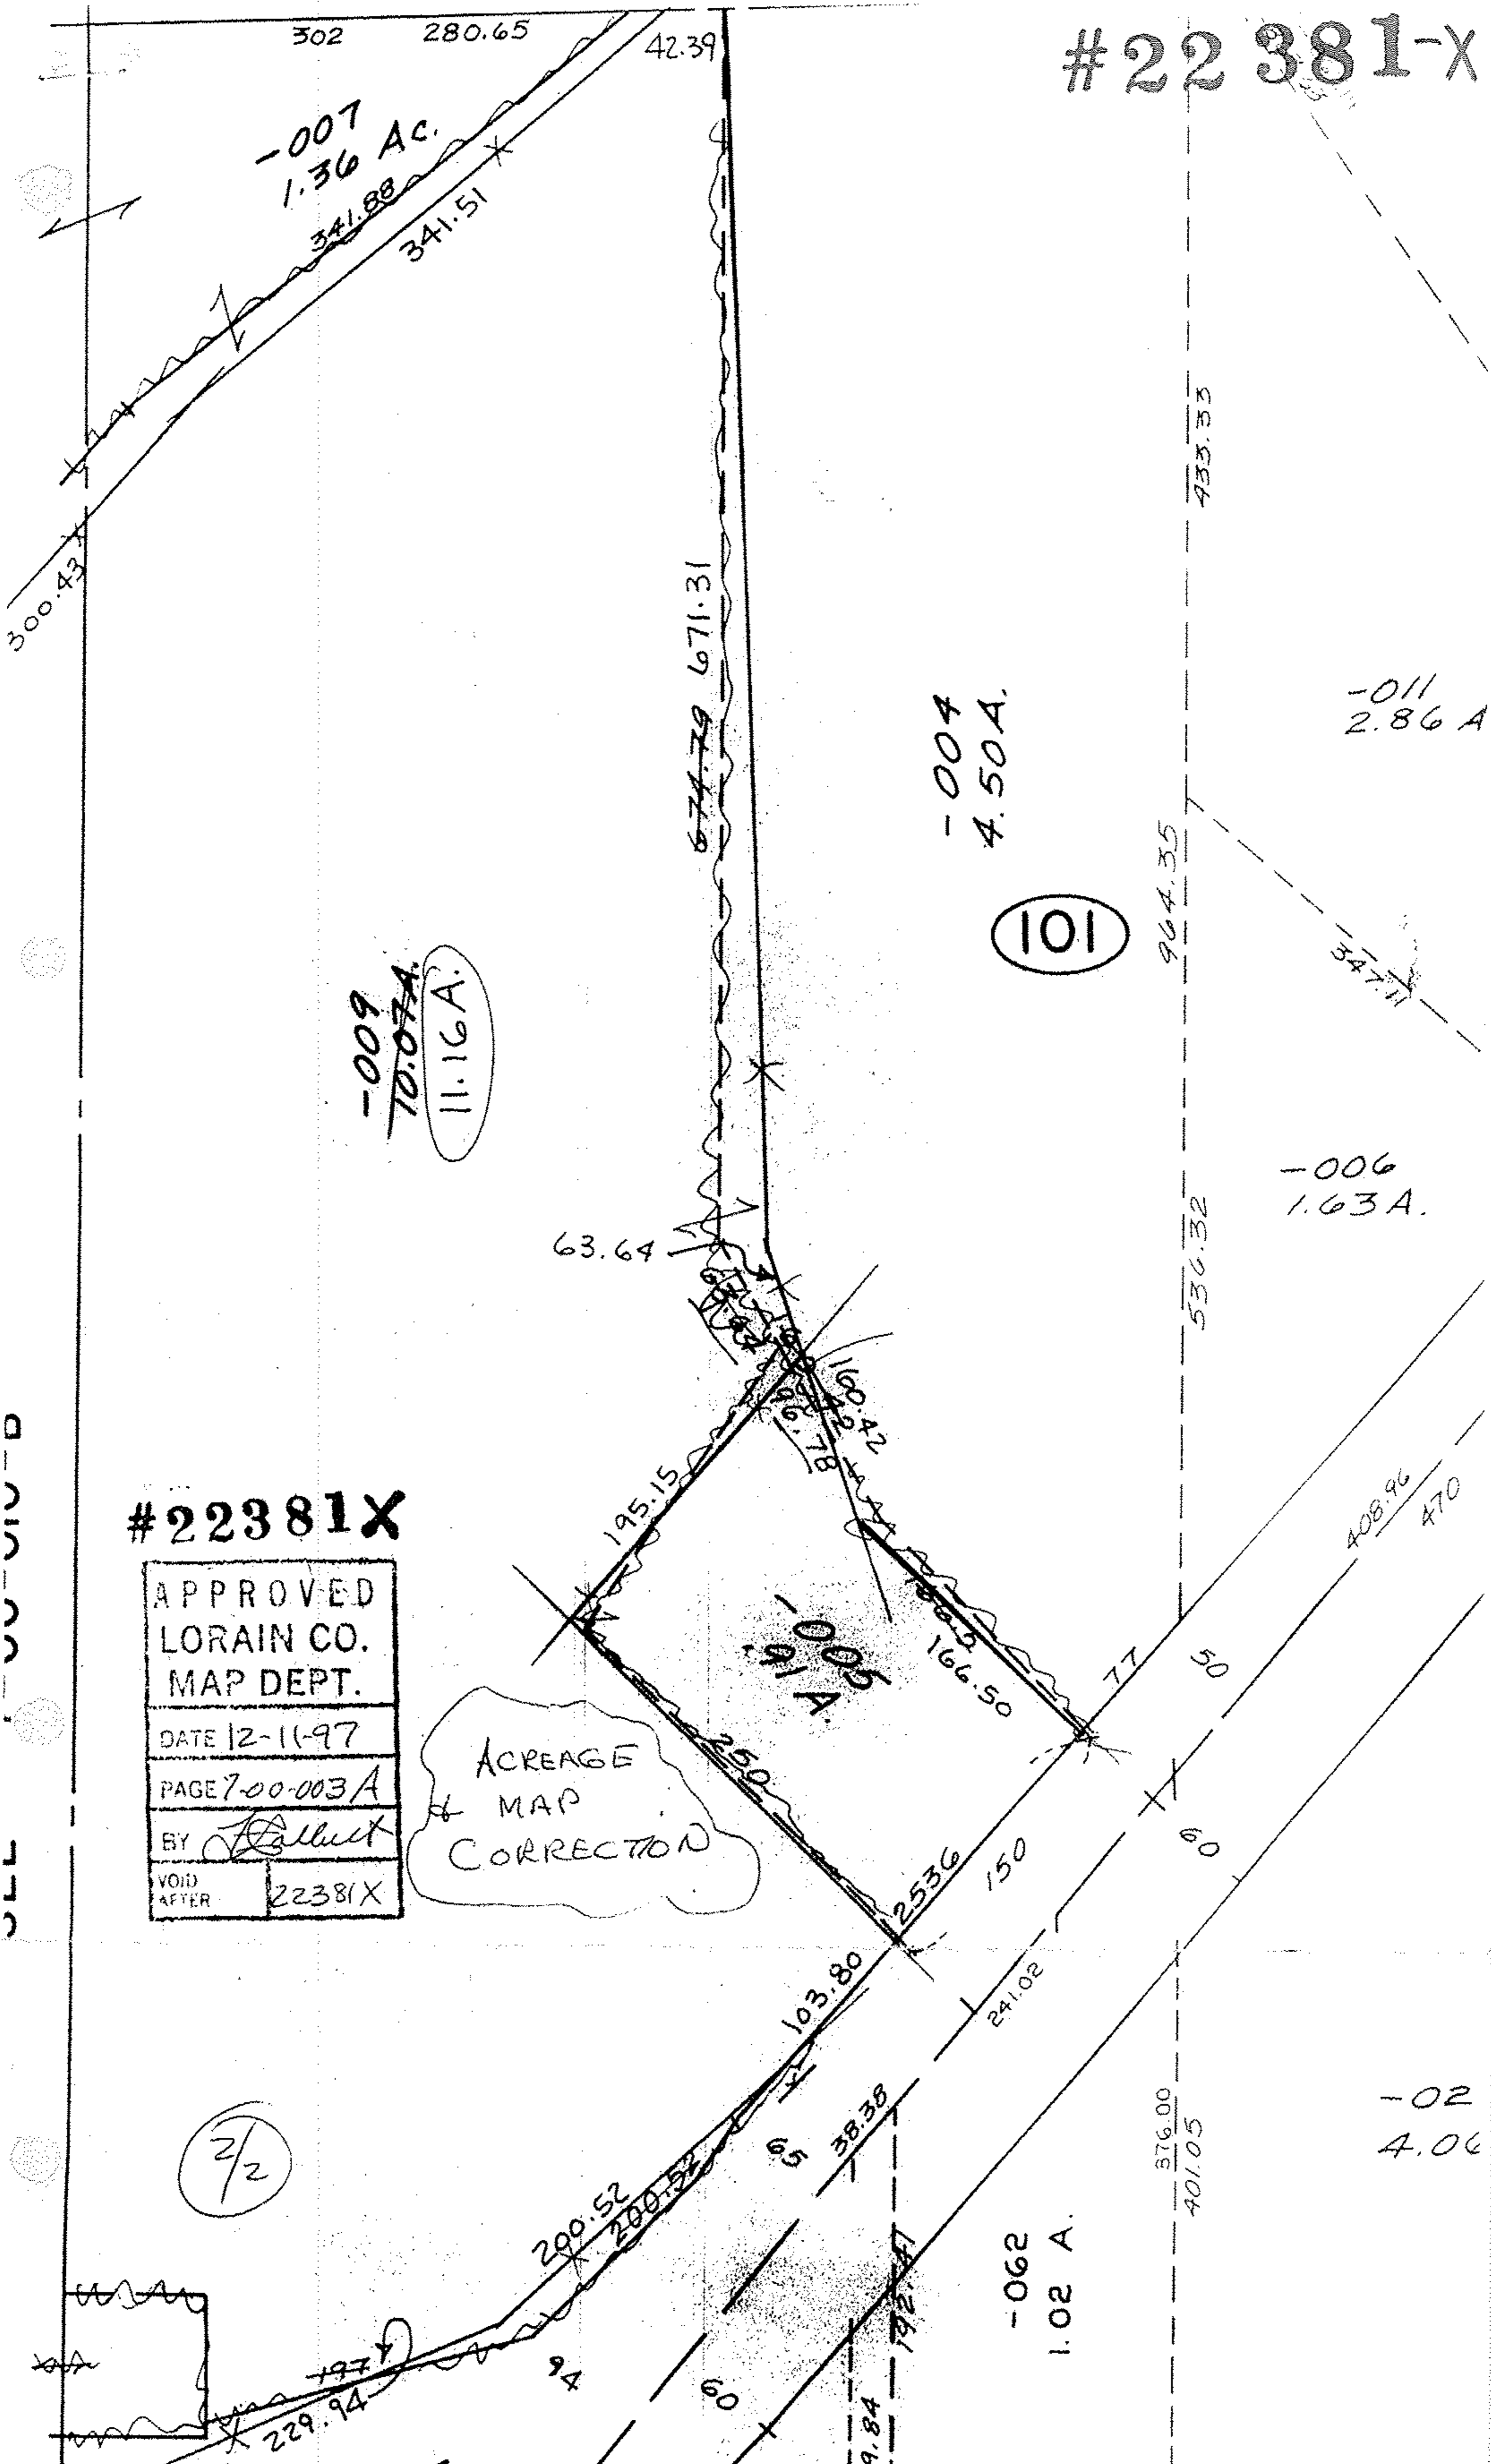

#22381X

APPROVED
LORAIN CO.
MAP DEPT.
DATE 12-11-97
PAGE 7-00-003A
BY <i>Hollist</i>
VOID AFTER 22381X

ACREAGE  
 & MAP  
 CORRECTION

2/2