

0.50 A



1 - 480

#22381X

-084
25.40 A.

APPROVED
LORAIN CO.
MAP DEPT.
DATE 12-11-97
PAGE 700-010 B
BY *J. G. Bell*

22381X

107
ACREAGE +
MAP
CORRECTION


-048
15.28 A
14.59 A.

SEE 7-00-003-A

Pt -010
Pt 67.25 A.

OHIO TURNPIKE

1/2

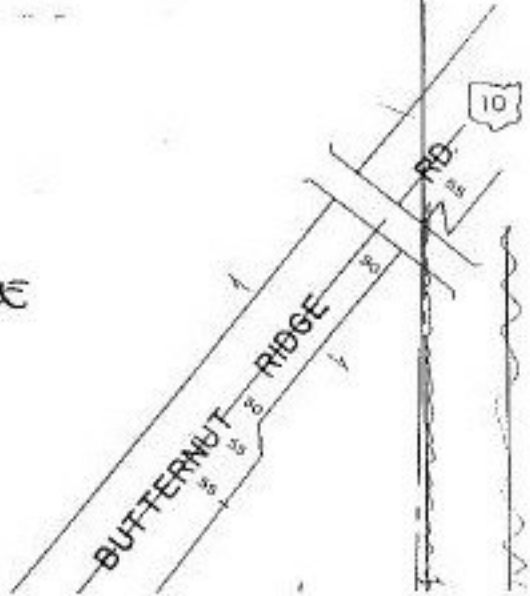

1000 02

200 15

100 05

100 05