


#22383  
NO. 22383

PARENT PARCEL: 03-00-012-000-157  
CHILD PARCEL: 03-00-012-000-158, 159  
STARTING POINT: cl. of Abbe Rd. & cl. of North Ridge Rd.

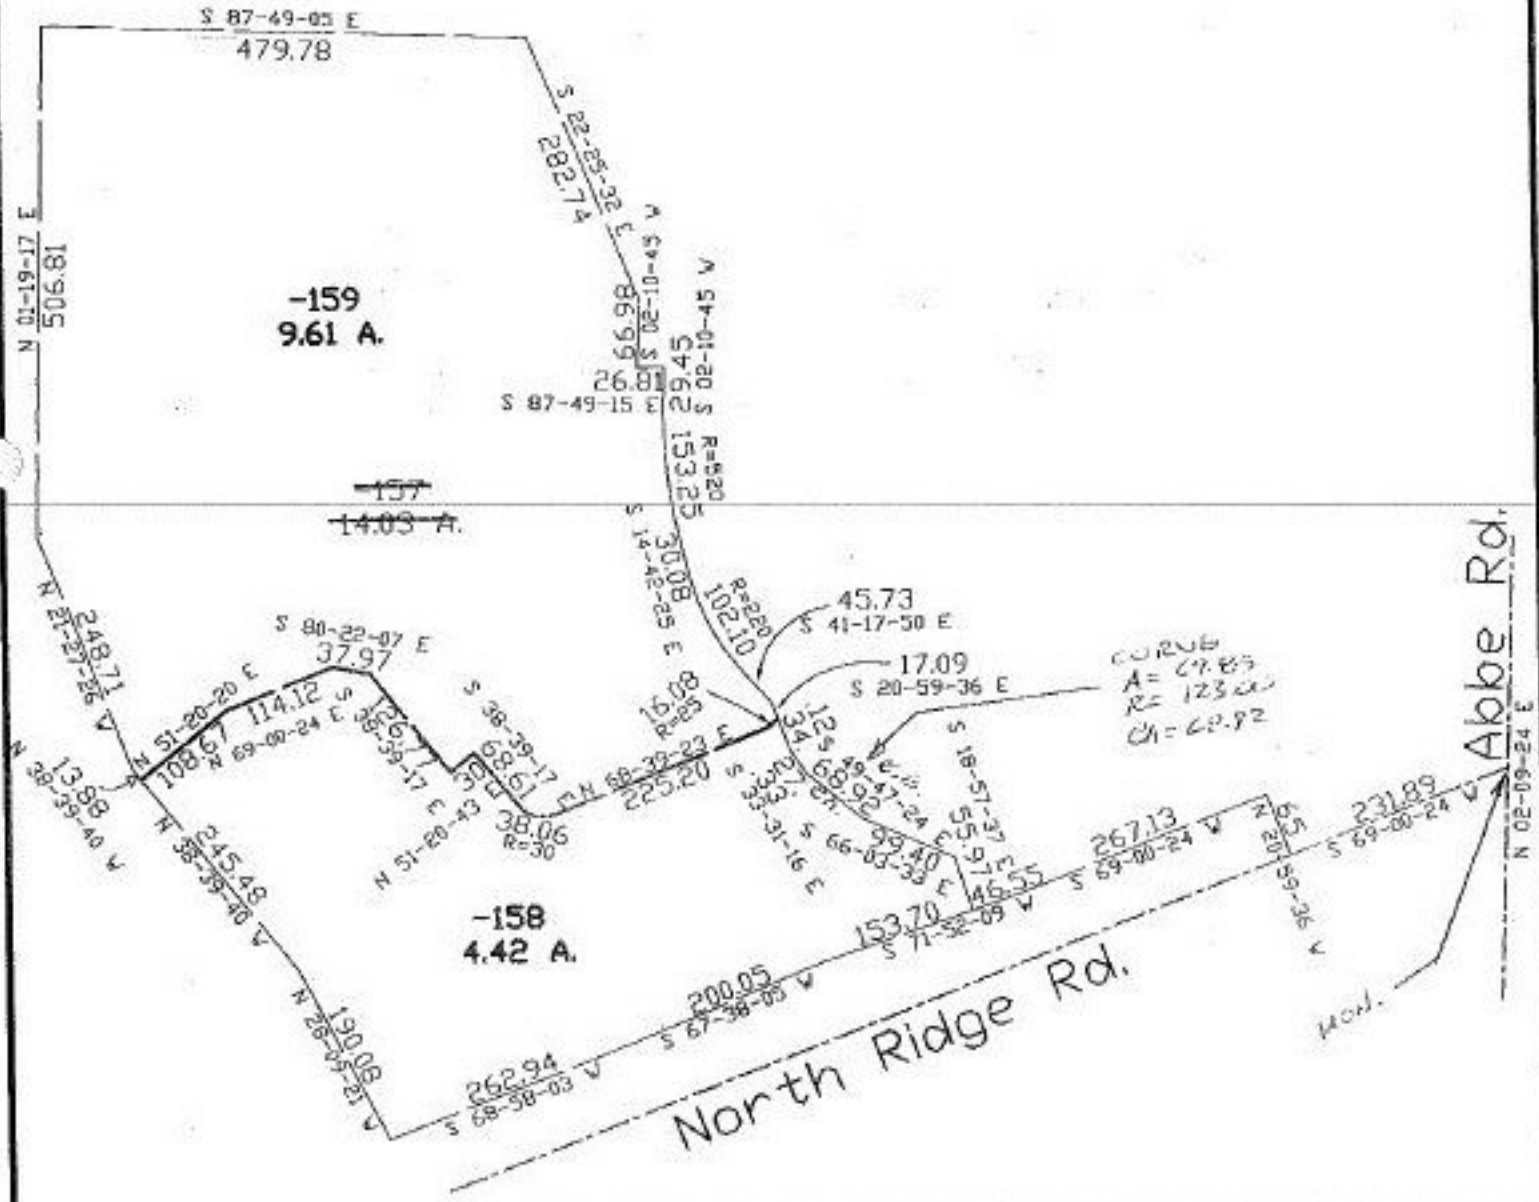

SPLITS/DEEDS PROCESSED  
LORAIN COUNTY TAX MAP DEPARTMENT  
226 MIDDLE AVE. ELYRIA, OHIO

SURVEYED BY: Mark Allen Yeager  
CLOSURE: 0.04:10.000  
MAP PAGE(S): 03-00-012-B  
APPROVED BY: kac DATE: 12/2/97  
SCALE: 1"=200' PRIOR INSTRUMENT: OR1310/887