
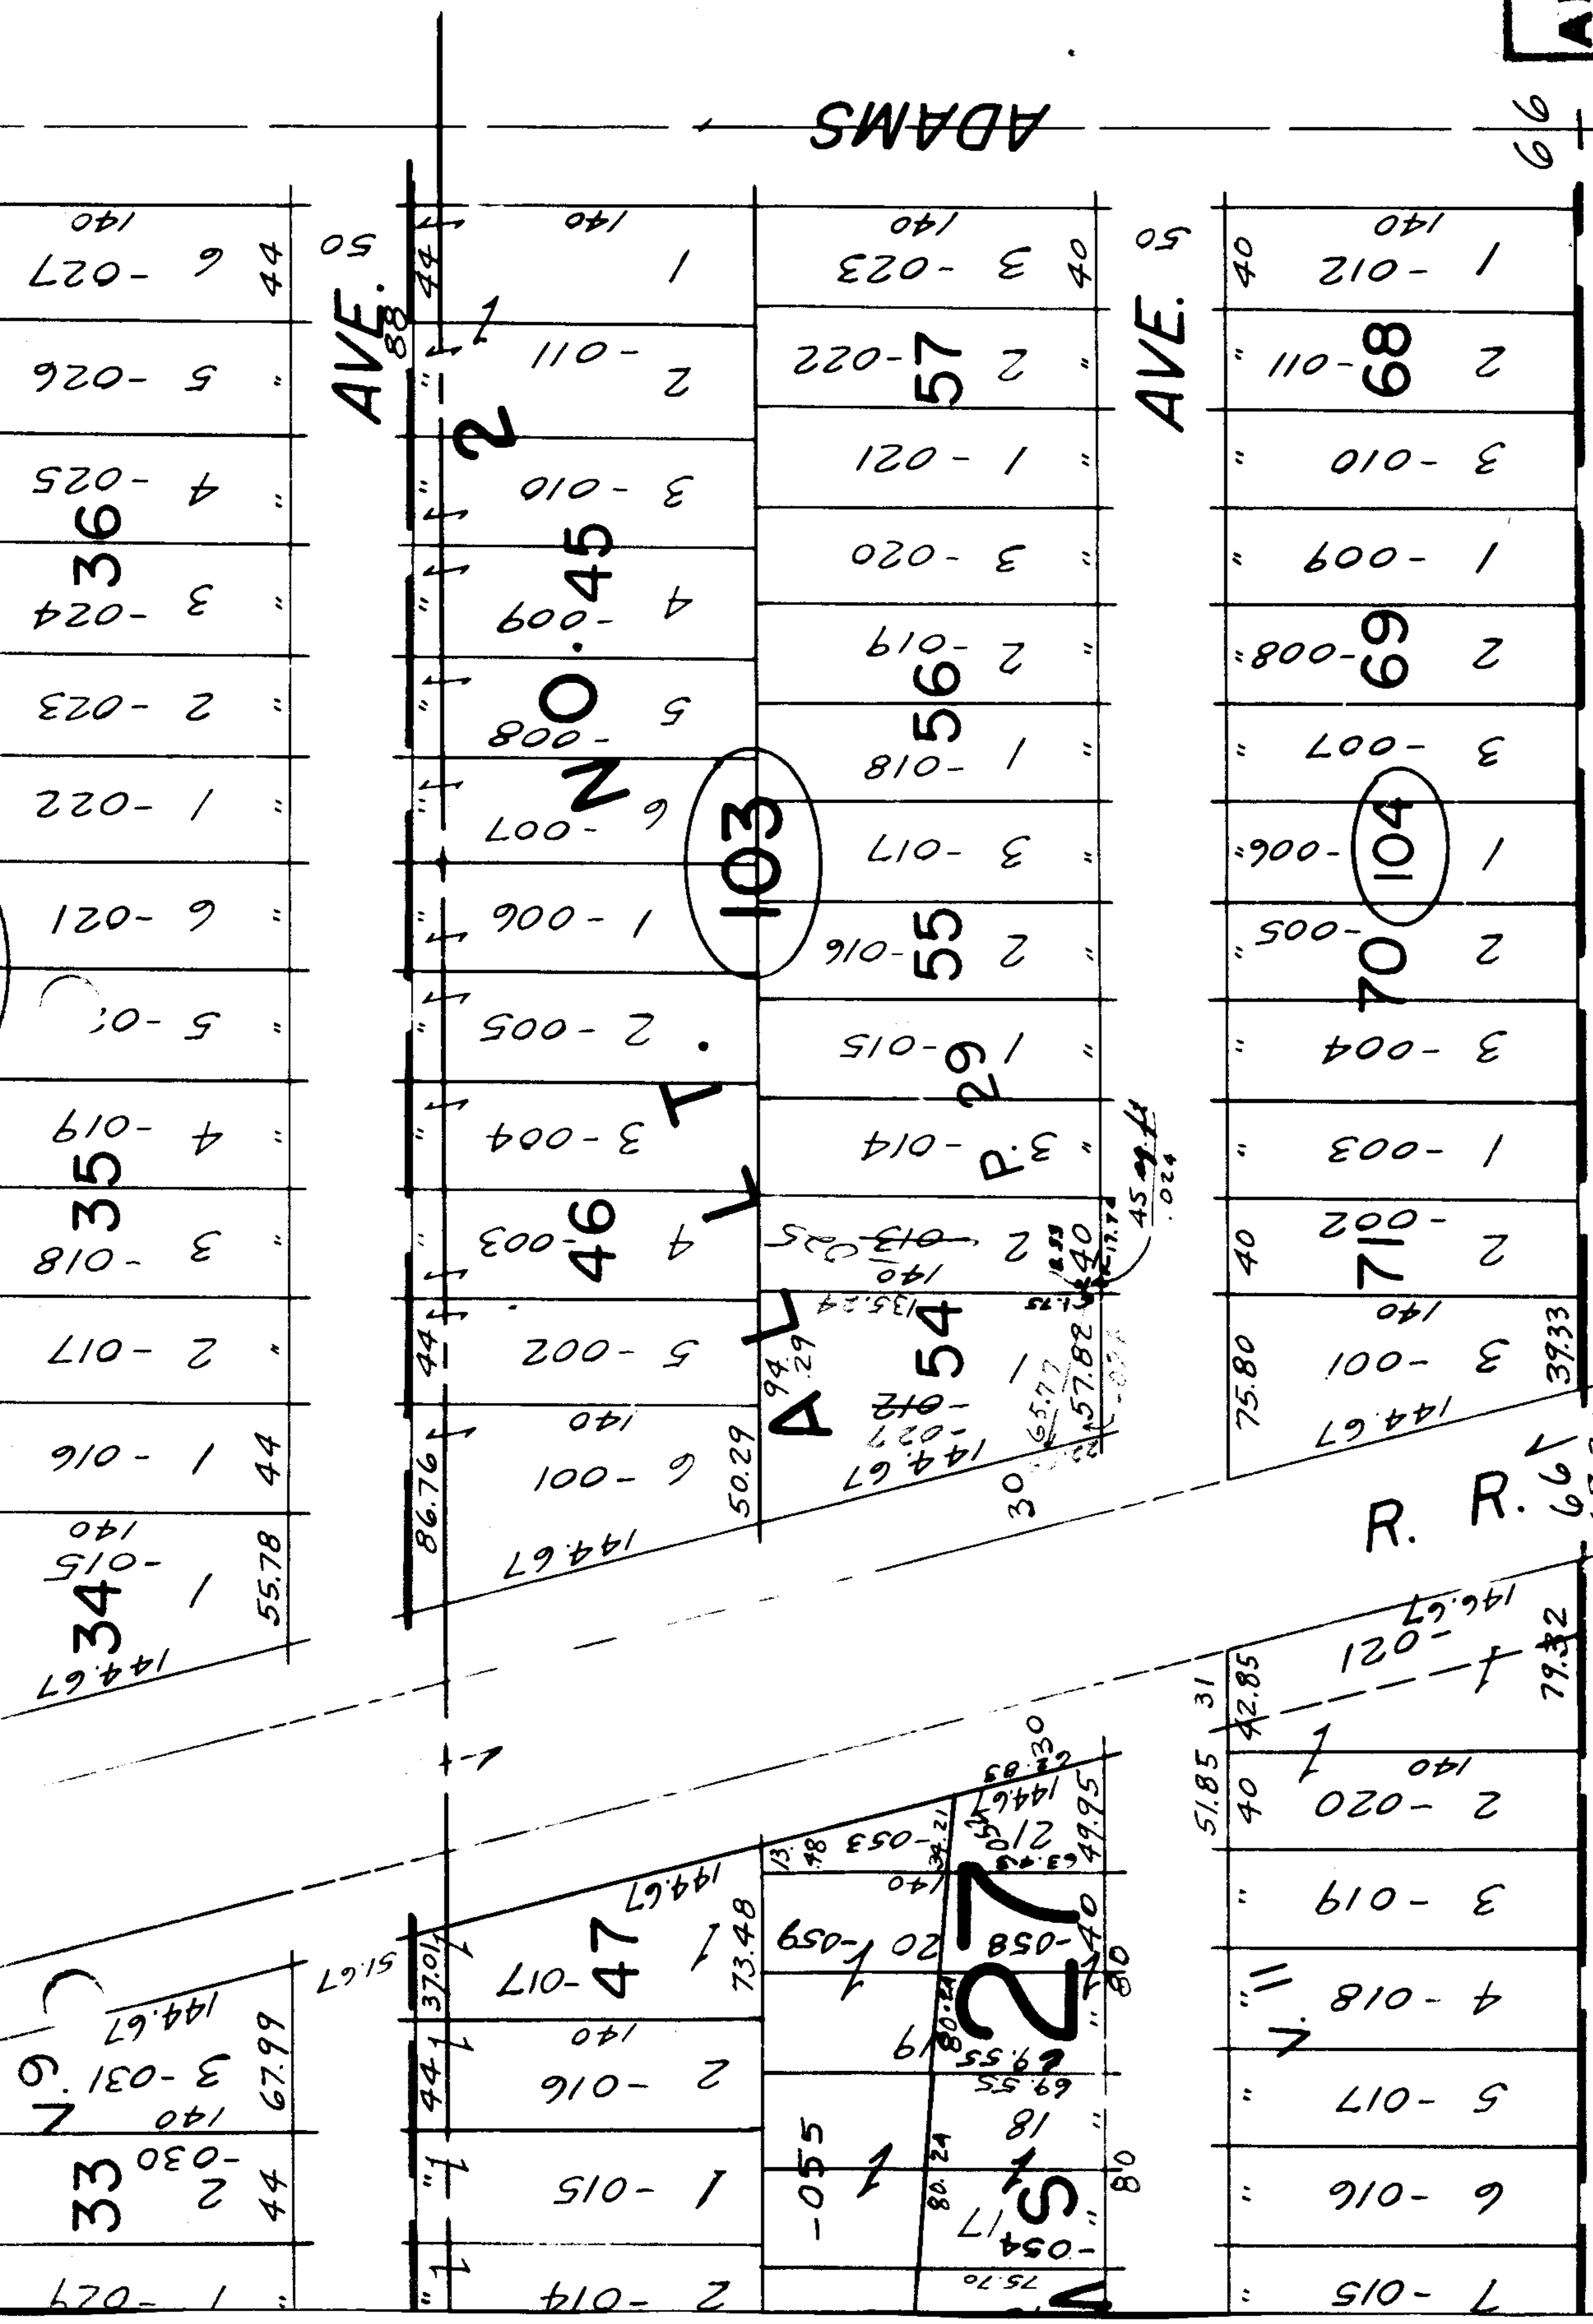


7

2239

APPROVED  
 LORAIN CO.  
 MAP DEPT.  
 DATE 11/13/68  
 BY R. L. Bell  
 RR

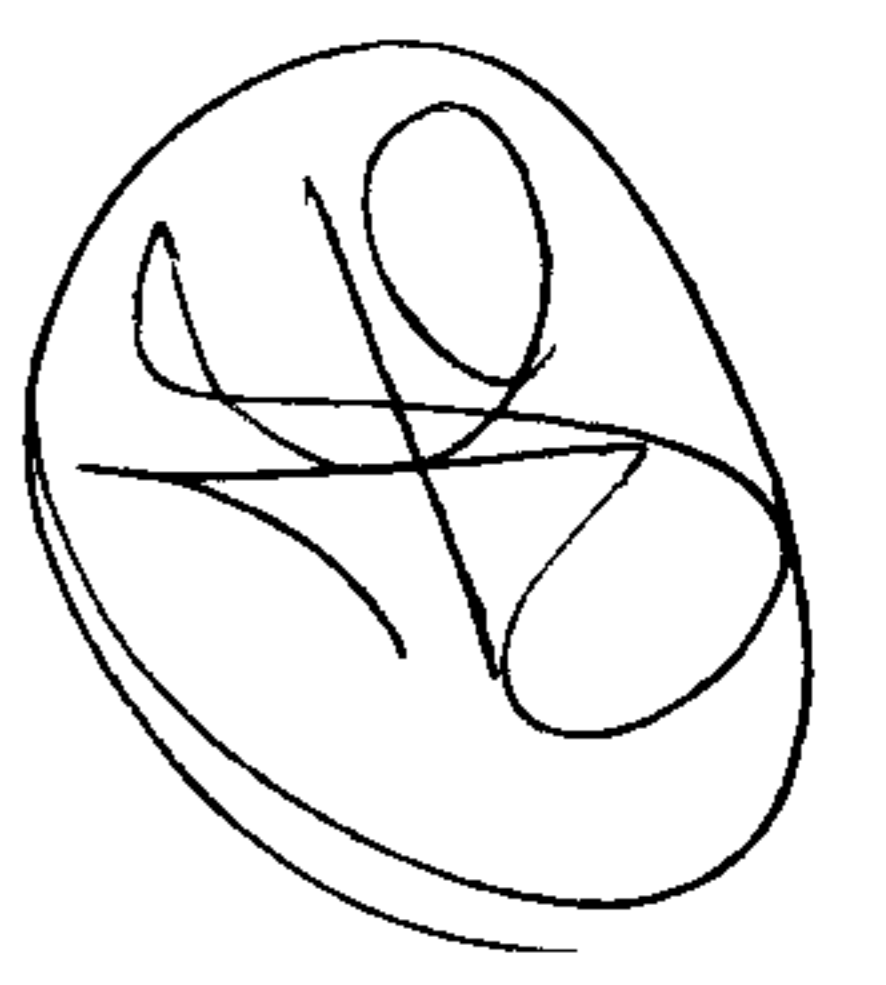

SEE 6-80

WEST OF RIVER  
 PT. LOTS 33, 34 & 27