



PARENT PARCEL: 02-01-008-101-123
 CHILD PARCEL: 02-01-008-101-375, 376
 STARTING POINT: c.L. of Oberlin Ave. & n. line of O.L. 8


NO. 22394

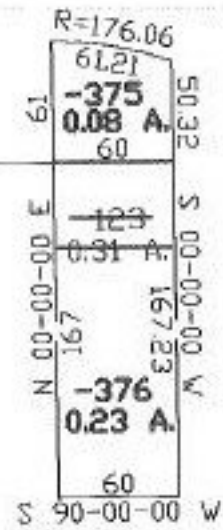

Oberlin Ave.

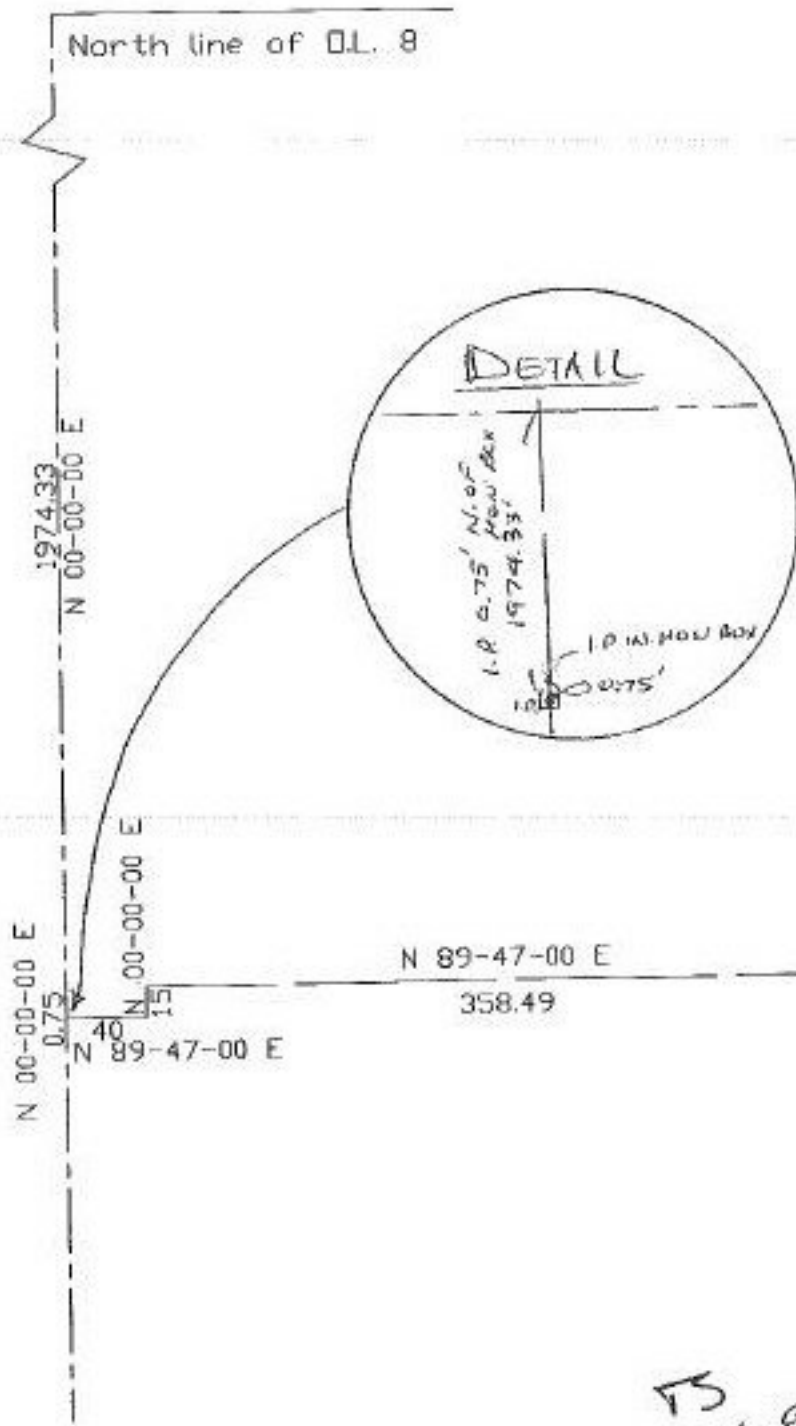

FS
2-25-99

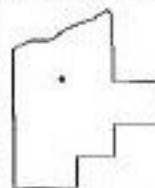

SPLITS/DEEDS PROCESSED
 LORAIN COUNTY TAX MAP DEPARTMENT
 226 MIDDLE AVE. ELYRIA, OHIO

SURVEYED BY: Douglas H. Masely
 CLOSURE: 019:10.000
 MAP PAGE(S): 02-01-008-A
 APPROVED BY: kac DATE: 12/29/97
 SCALE: 1" = 100' PRIOR INSTRUMENT: 964/932