

PARENT PARCEL: 02-01-008-101-188

CHILD PARCEL: 02-01-008-101-377, 378



STARTING POINT: c. of Oberlin Ave. & n. line of O.L. 8

NO. 22395



Oberlin Ave.

North line of O.L. 8

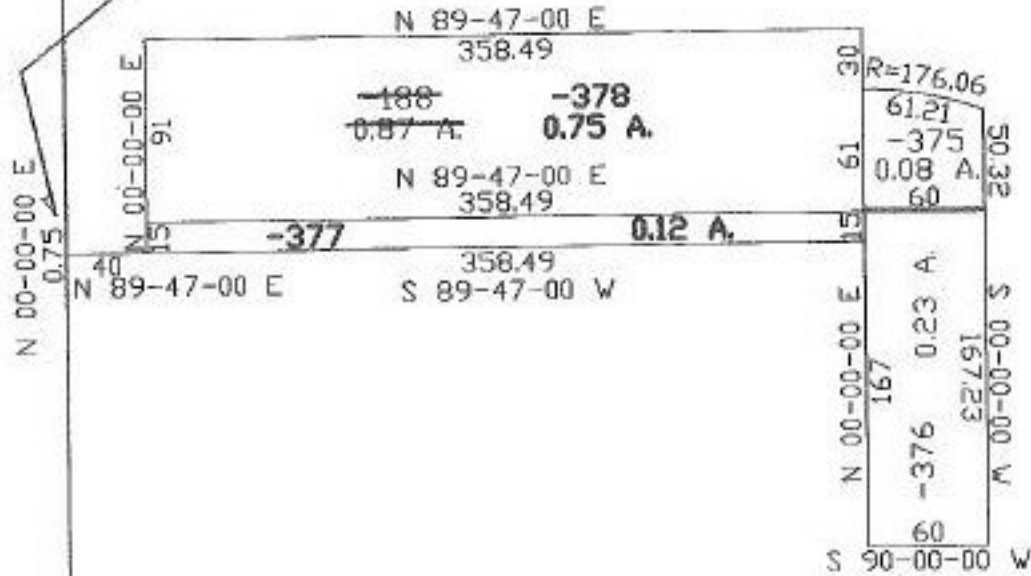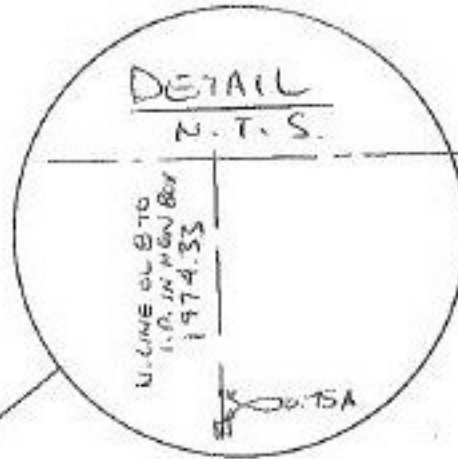

TS  
2-25-99



**SPLITS/DEEDS PROCESSED**  
LORAIN COUNTY TAX MAP DEPARTMENT  
226 MIDDLE AVE. ELYRIA, OHIO

SURVEYED BY: Douglas H. Masely  
CLOSURE: 0.00:10.000  
MAP PAGE(S): 02-01-008-A  
APPROVED BY: kac DATE: 12/29/97  
SCALE: 1" = 100' PRIOR INSTRUMENT: