


PARENT PARCEL: 07-00-046-108-004, 039, 040, 041, 042
 CHILD PARCEL: 07-00-046-108-053, 054, 055, 056
 STARTING POINT: c.l. of Center Ridge Rd. & w. line of Ridgeville Twp.

NO. 22401

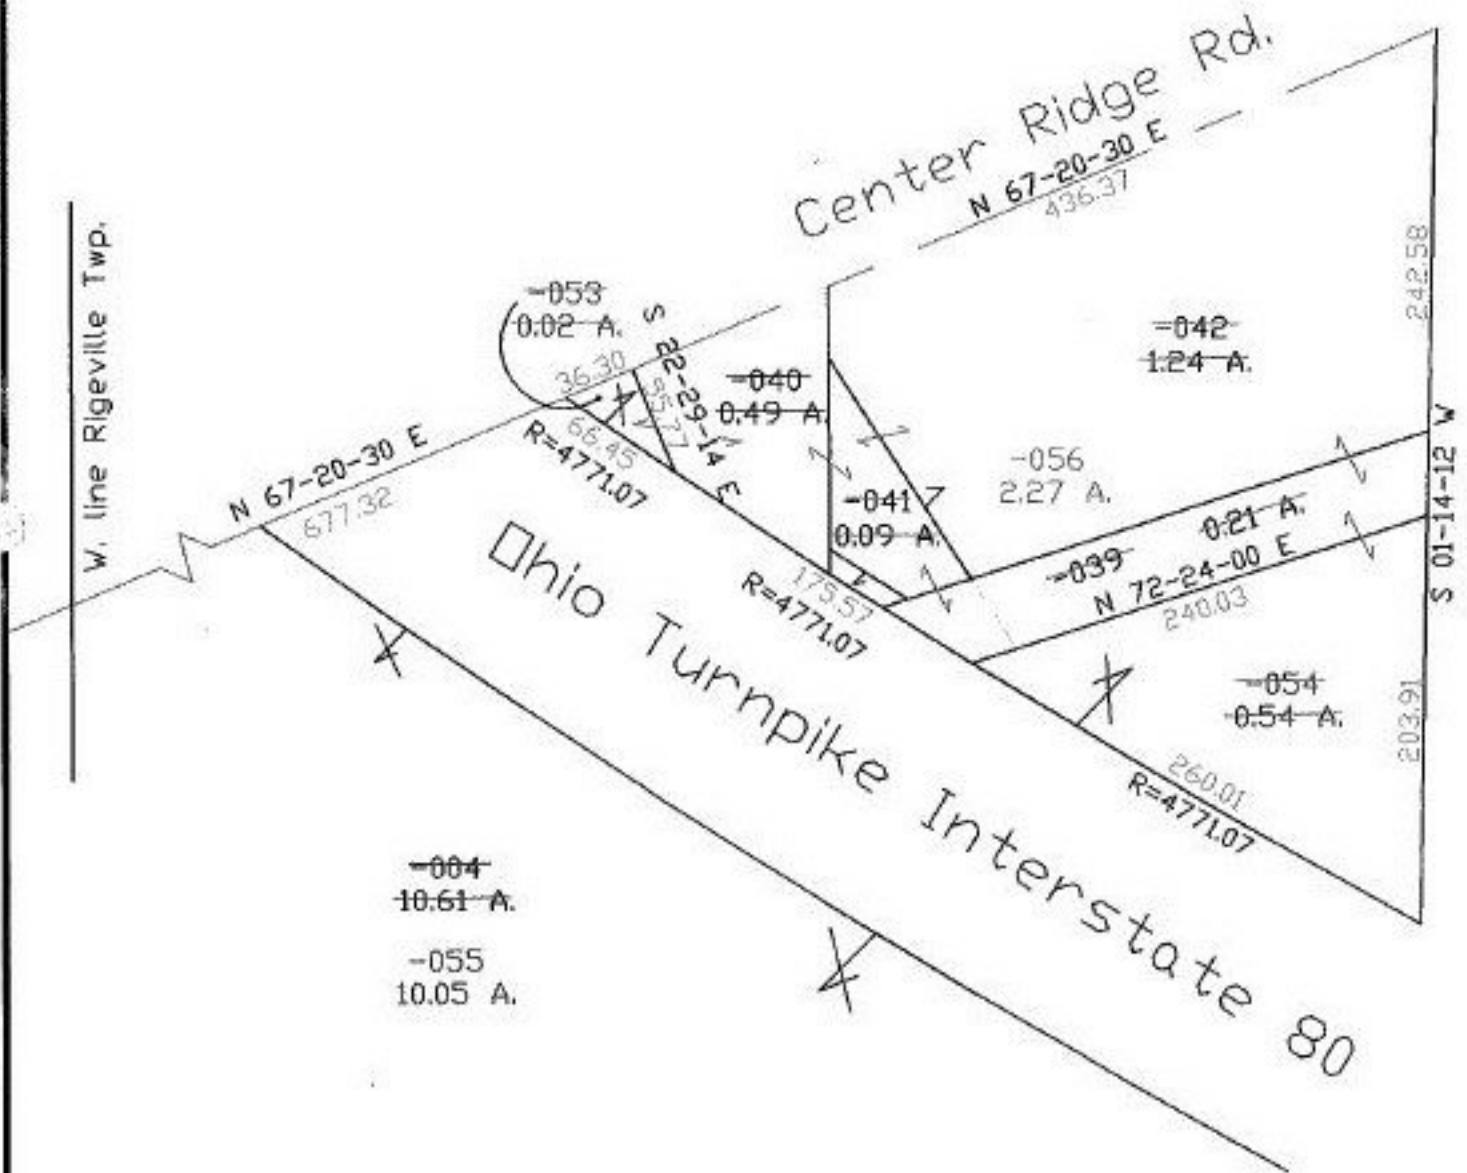

SPLITS/DEEDS PROCESSED
 LORAIN COUNTY TAX MAP DEPARTMENT
 226 MIDDLE AVE. ELYRIA, OHIO

SURVEYED BY: David L. Elwell
 CLOSURE: 0.25:10.000
 MAP PAGE(S): 7-00-046-C SCALE: 1"= 100
 APPROVED BY: kac DATE: 1/8/98
 PRIOR INSTRUMENT: OR 909/637 OR 1004/733