

PARENT PARCEL: 03-00-014-000-024, 025


CHILD PARCEL:

STARTING POINT:

NO. 22405-A



MAP CORRECTION  
ADD ACREAGE TO PARCELS -024 AND -025  
PER DV 667/288 AND MAP DEPT. CALCULATIONS

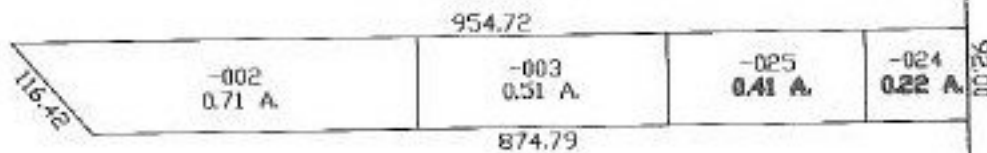

REGISTER & DUPLICATE CORRECTION  
ACREAGE CORRECTION FOR PARCELS -024 & -025  
PER DV 667/288 AND MAP DEPT. CALCULATIONS

-025	-024
<del>0.42 A.</del>	<del>0.21 A.</del>
0.41 A.	0.22 A.

CORR. PER DV 667/288 &  
MAP DEPT. CALC.



**SPLITS/DEEDS PROCESSED**  
LORAIN COUNTY TAX MAP DEPARTMENT  
226 MIDDLE AVE. ELYRIA, OHIO

SURVEYED BY: \_\_\_\_\_  
 CLOSURE: \_\_\_\_\_  
 MAP PAGE(S): **03-00-014-B**  
 APPROVED BY: KAC DATE: 1/22/98  
 SCALE: 1" = 200' PRIOR INSTRUMENT: \_\_\_\_\_