


#22407-X

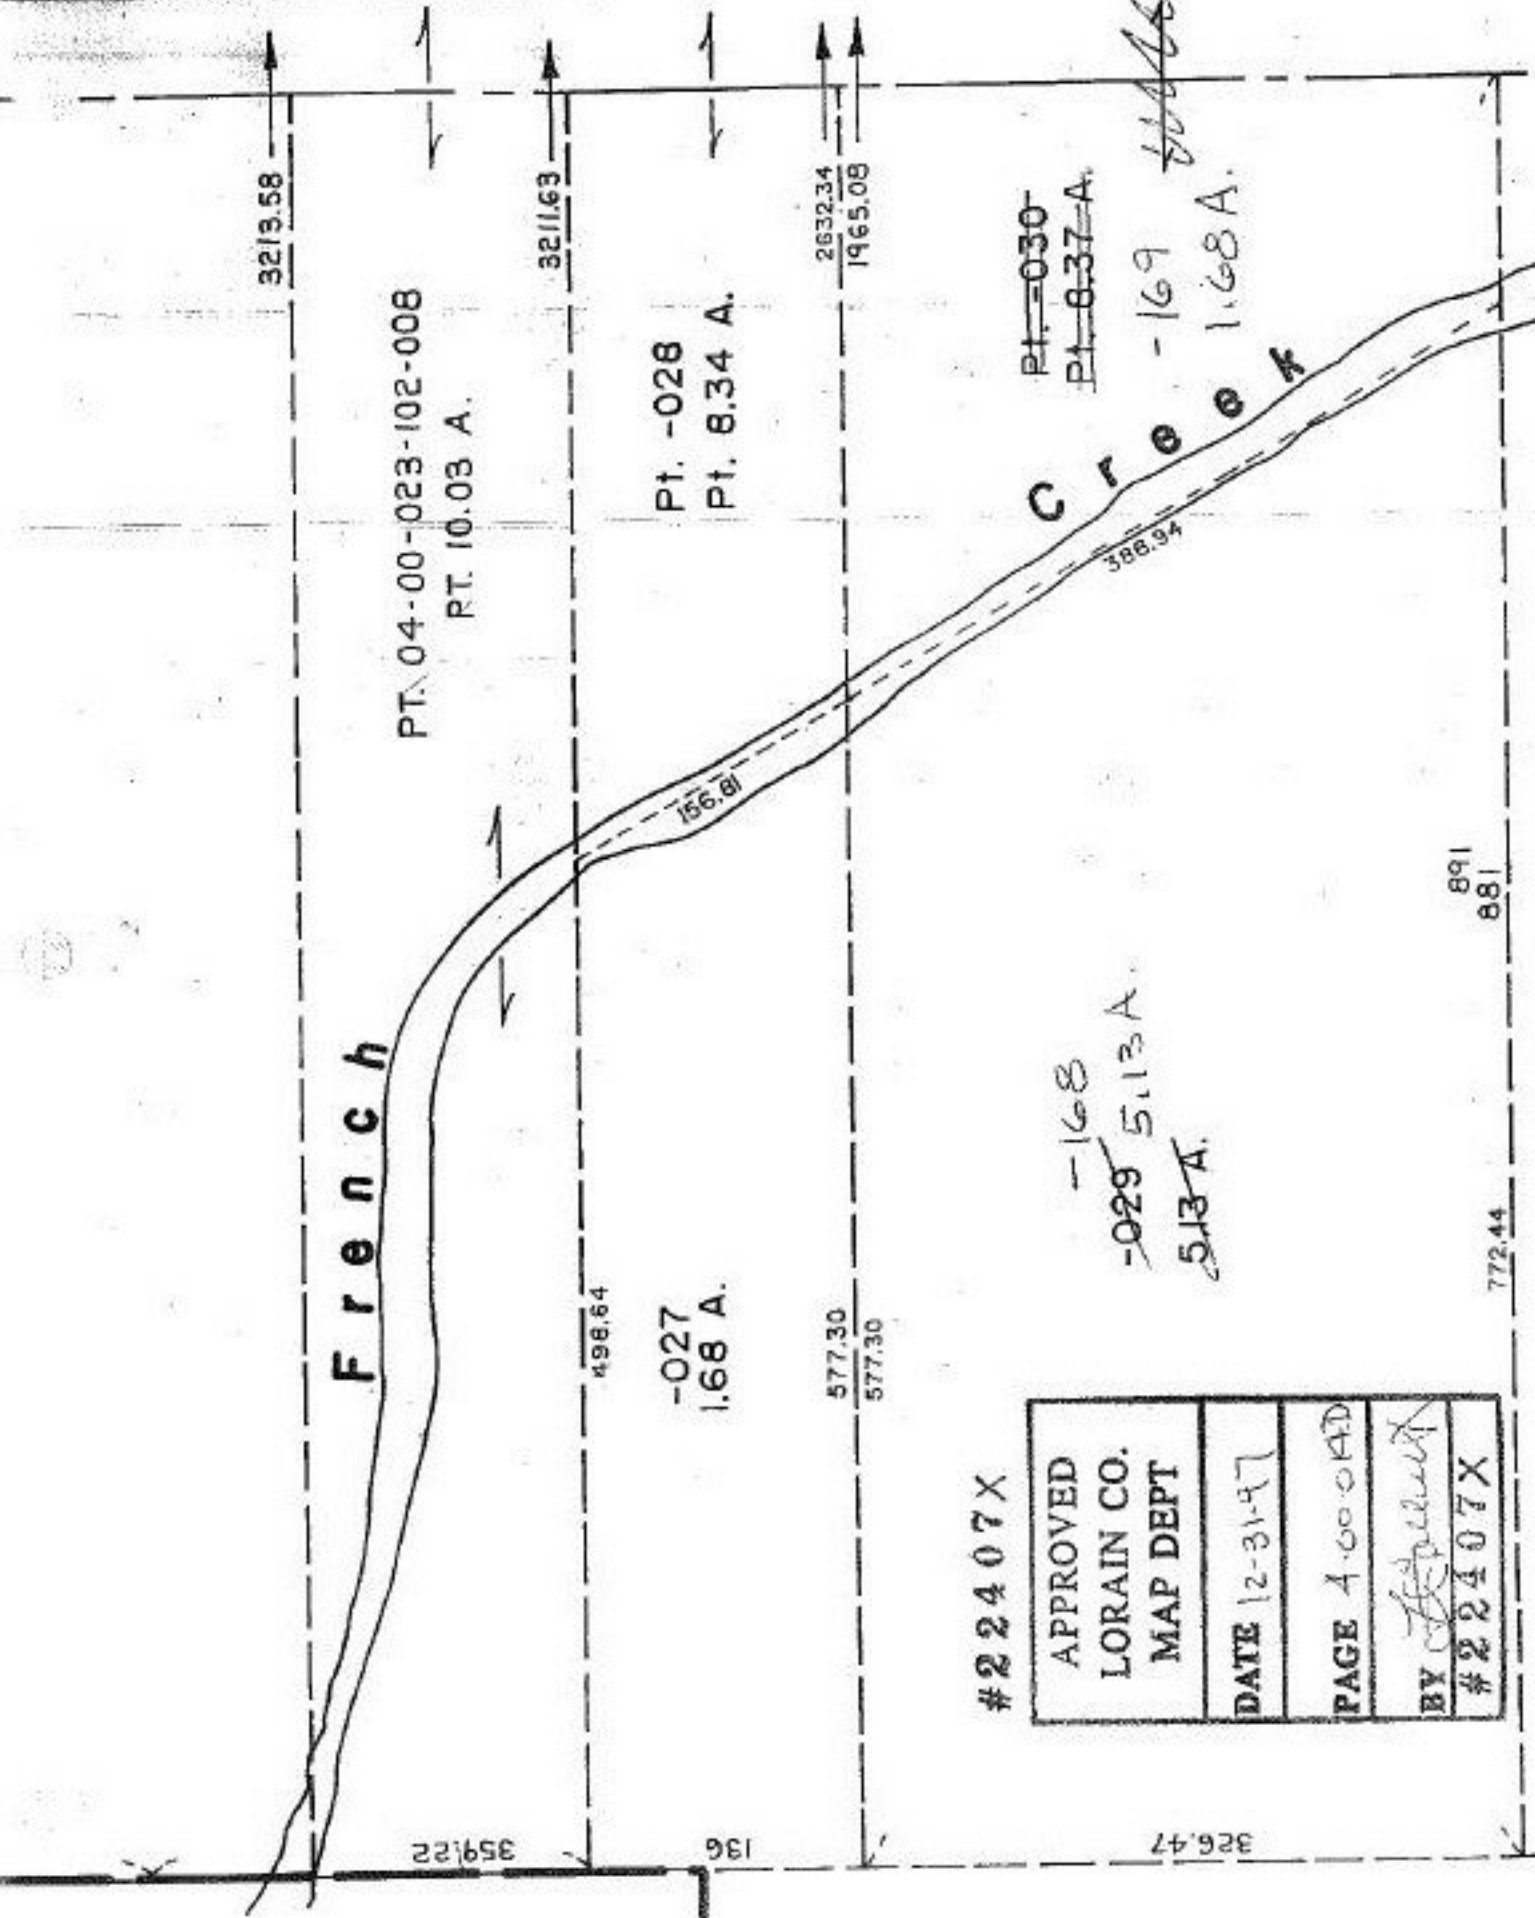

PT. 04-00-023-102-008
RT. 10.03 A.

Pt. -028
Pt. 6.34 A.

-027
1.68 A.

~~Pt. -030~~
~~Pt. 6.37 A.~~

~~-169~~ 1.68 A.

~~-168~~
~~-029~~ 5.13 A.
5.13 A.

#22407X

APPROVED LORAIN CO. MAP DEPT
DATE 12-31-97
PAGE 4-00-014-D
BY <i>[Signature]</i>
#22407X

SEE 4-00-014-H 4-00-014-D