


#22409-A

186-38

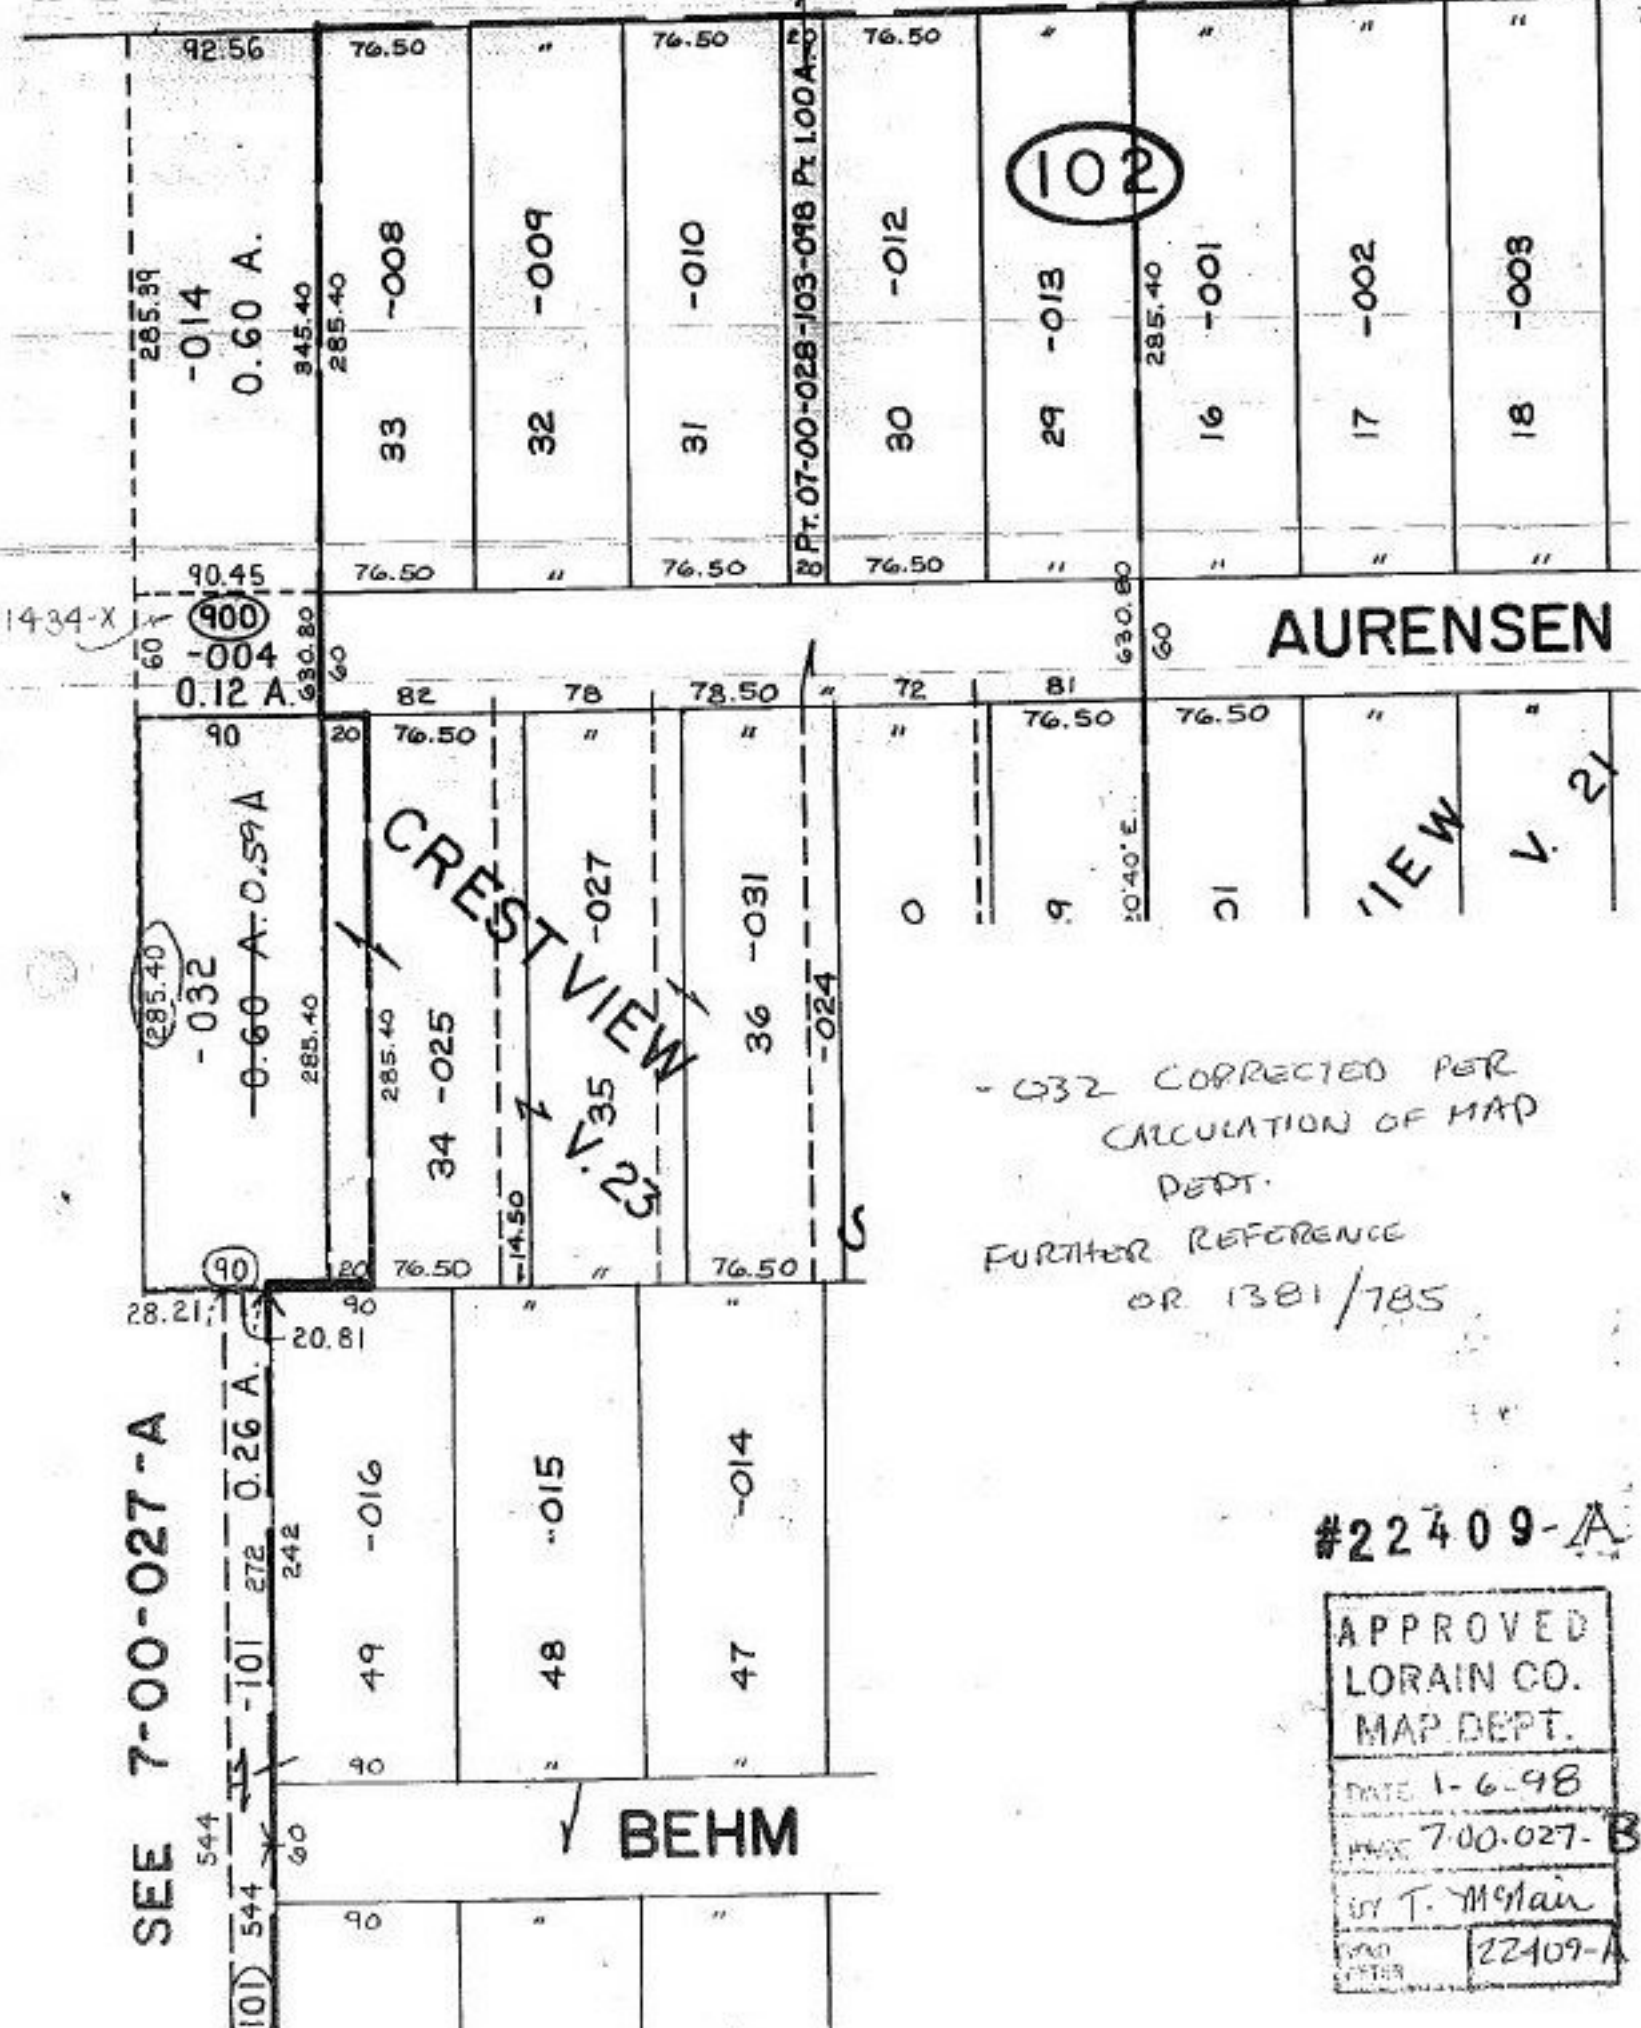

AURENSEN

BEHM

- 032 CORRECTED PER
CALCULATION OF MAP
DEPT.
FURTHER REFERENCE
OR 1381/785

SEE 7-00-027-A

#22409-A

APPROVED
LORAIN CO.
MAP DEPT.
DATE 1-6-98
PAGE 7-00-027-B
BY T. McLean
22409-A