

PARENT PARCEL: 01-00-056-000-038


CHILD PARCEL:

STARTING POINT: cl. of Middle Ridge Rd. & w. line of O.L. 56

NO. 22411-X




P.O.B
IP FD

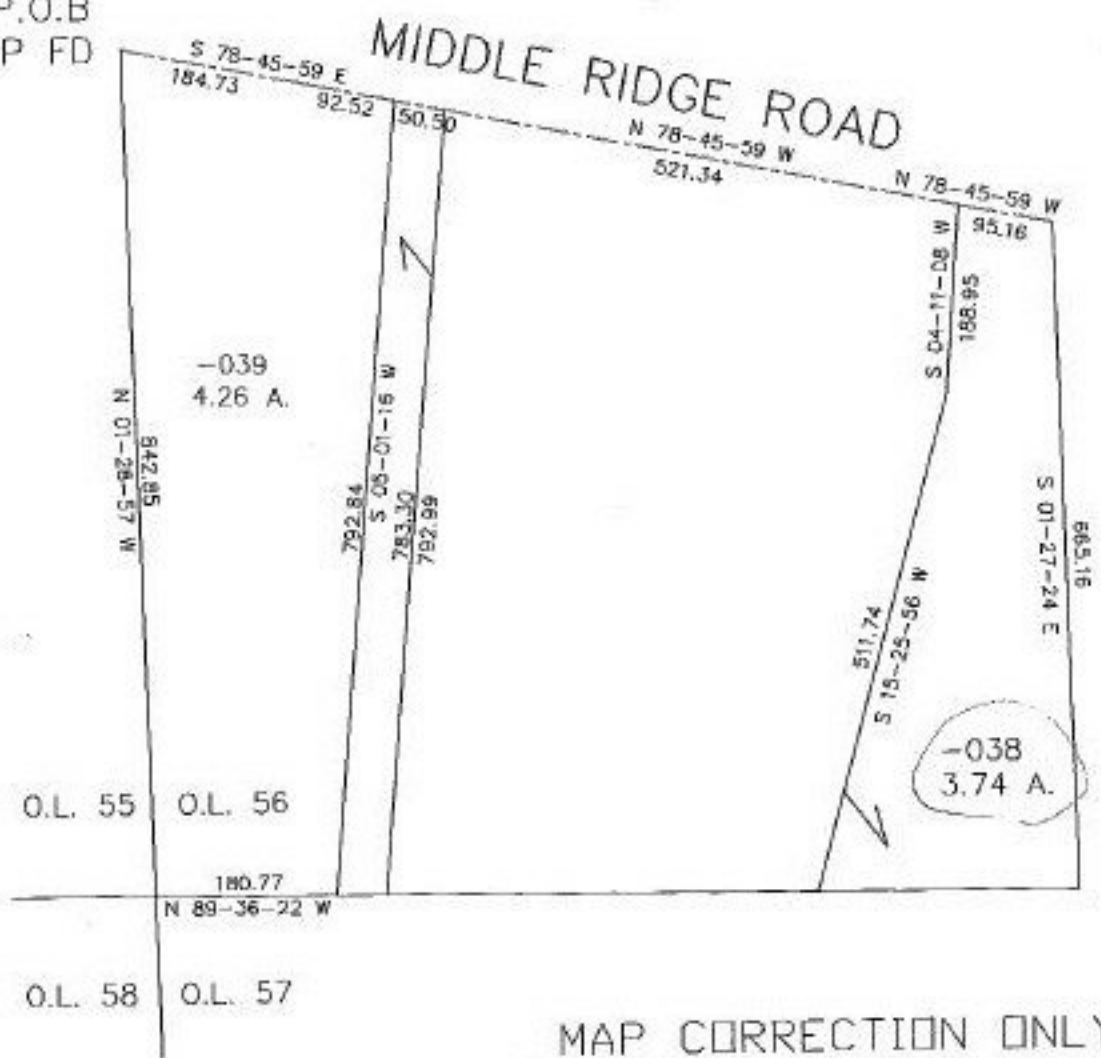

MAP CORRECTION ONLY
ADD HOOK ON PARCEL -038

TS
2-10-99 CRIP
3/29/99

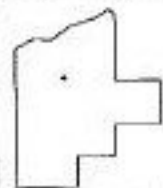

SPLITS/DEEDS PROCESSED
LORAIN COUNTY TAX MAP DEPARTMENT
226 MIDDLE AVE. ELYRIA, OHIO

SURVEYED BY: Richard Rosebeck
CLOSURE: _____
MAP PAGE(S): 1-1
APPROVED BY: TAM DATE: 1/17/98
SCALE: 1"=200'