
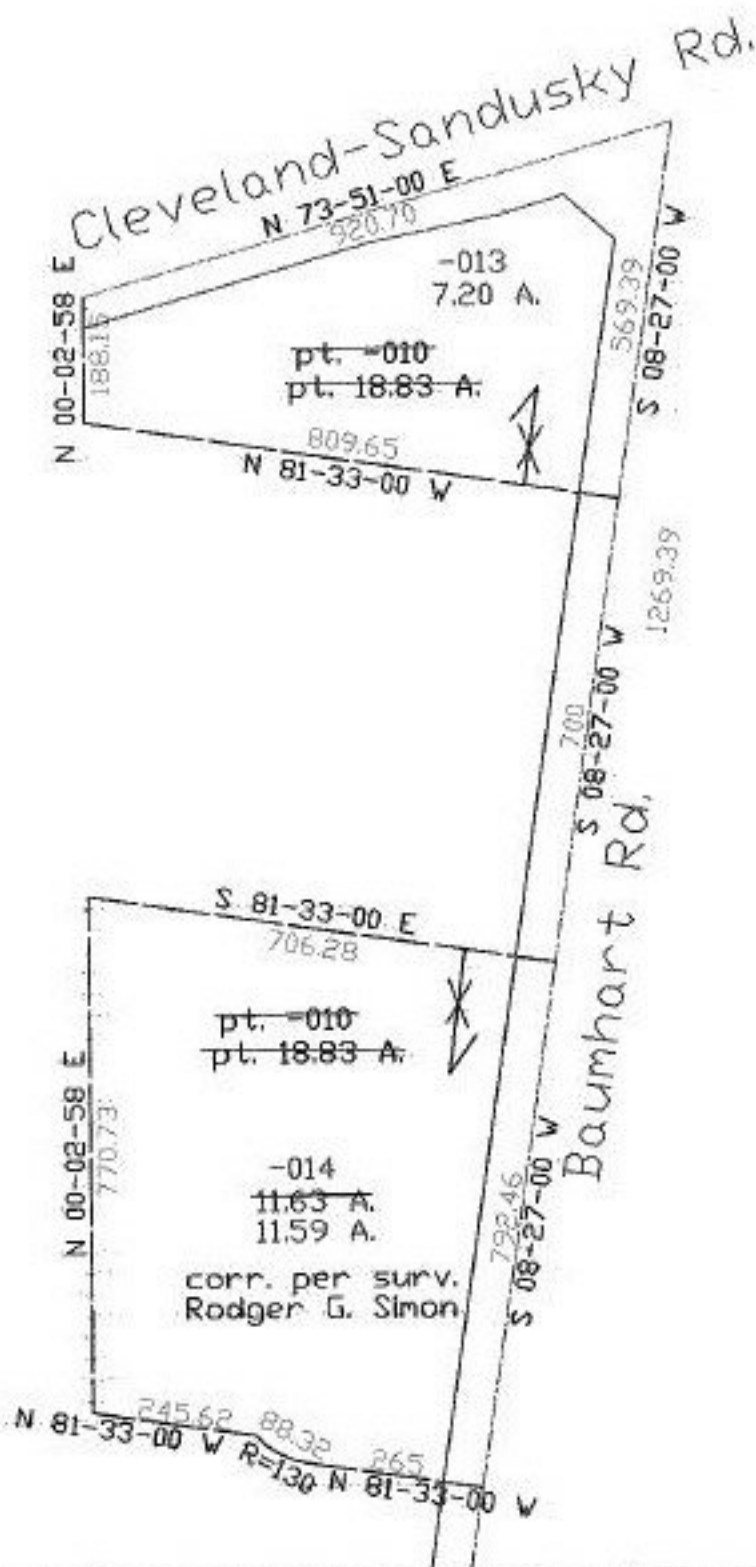


PARENT PARCEL: 01-00-007-102-010

CHILD PARCEL: 01-00-007-102-013, 014

STARTING POINT: cl. of Baumhart Rd. & cl. of Cleveland-Sandusky Rd.

NO. 22411

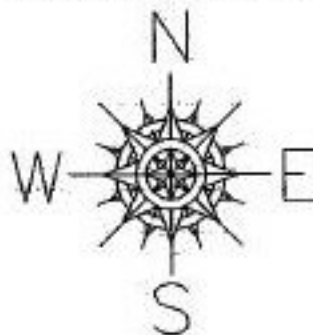

SPLITS/DEEDS PROCESSED
LORAIN COUNTY TAX MAP DEPARTMENT
 226 MIDDLE AVE. ELYRIA, OHIO

SURVEYED BY: Rodger G. Simon
 CLOSURE: 0.05:10,000
 MAP PAGE(S): 1-D
 APPROVED BY: kac DATE: 1/23/98
 SCALE: 1" = 300' PRIOR INSTRUMENT: OR 984/455