


PARENT PARCEL: 04-00-008-101-048

CHILD PARCEL: 04-00-008-101-050, 051

STARTING POINT: cl. of Center Rd. & cl. of Webber Rd.

NO. 22412

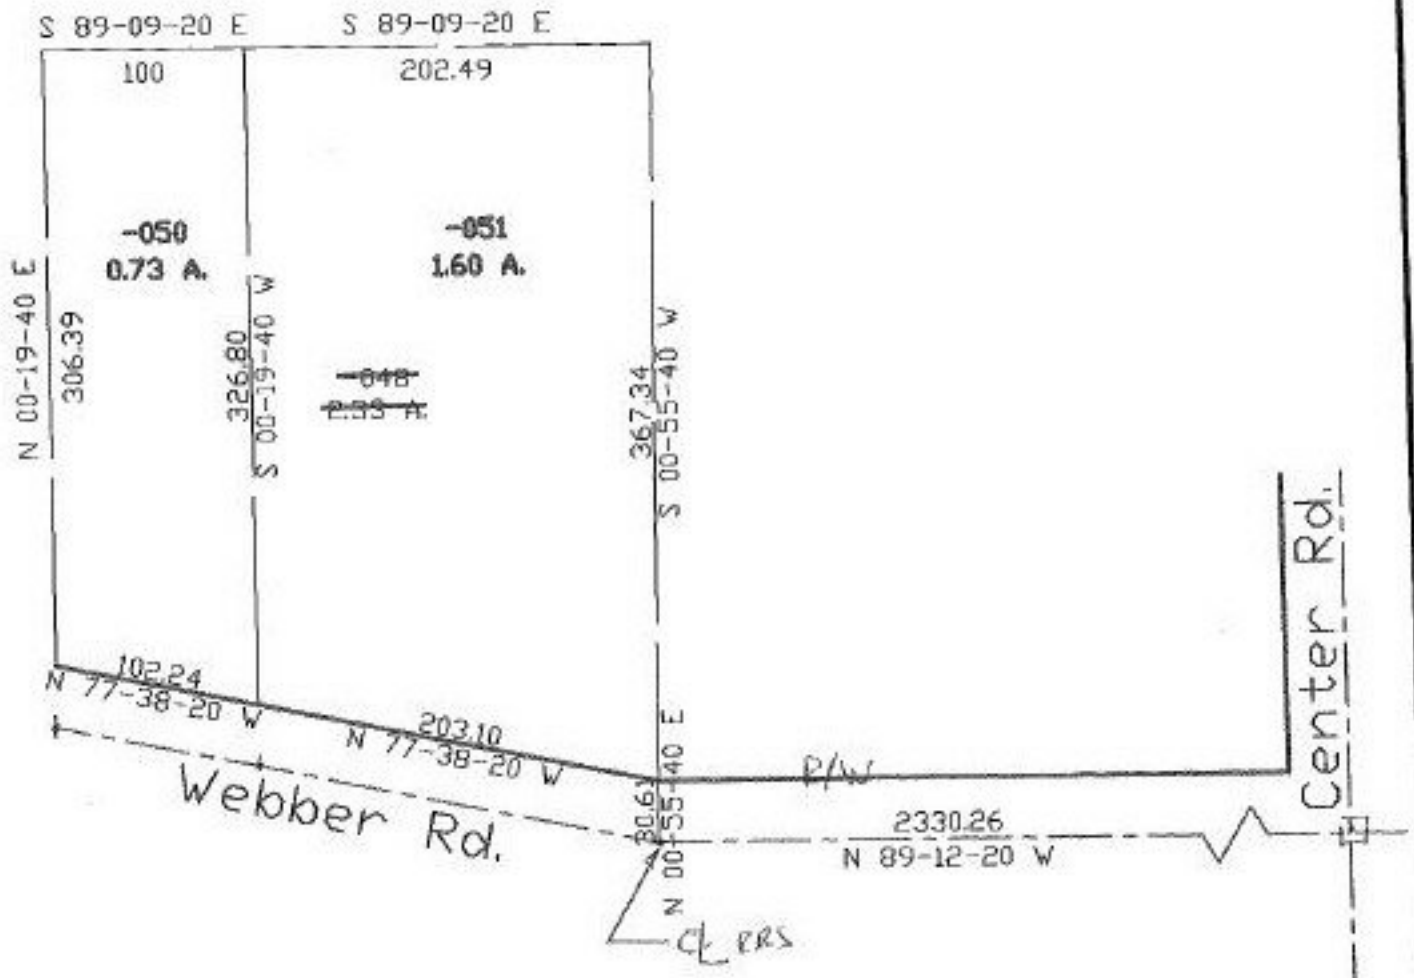

SPLITS/DEEDS PROCESSED
 LORAIN COUNTY TAX MAP DEPARTMENT
 226 MIDDLE AVE. ELYRIA, OHIO

SURVEYED BY: James A. Resor
 CLOSURE: 0.06:10,000
 MAP PAGE(S): 4-8
 APPROVED BY: koc DATE: 1/23/98
 SCALE: 1" = 100' PRIOR INSTRUMENT: #97497063