


4-00-023-

SEE 4-00-023-C

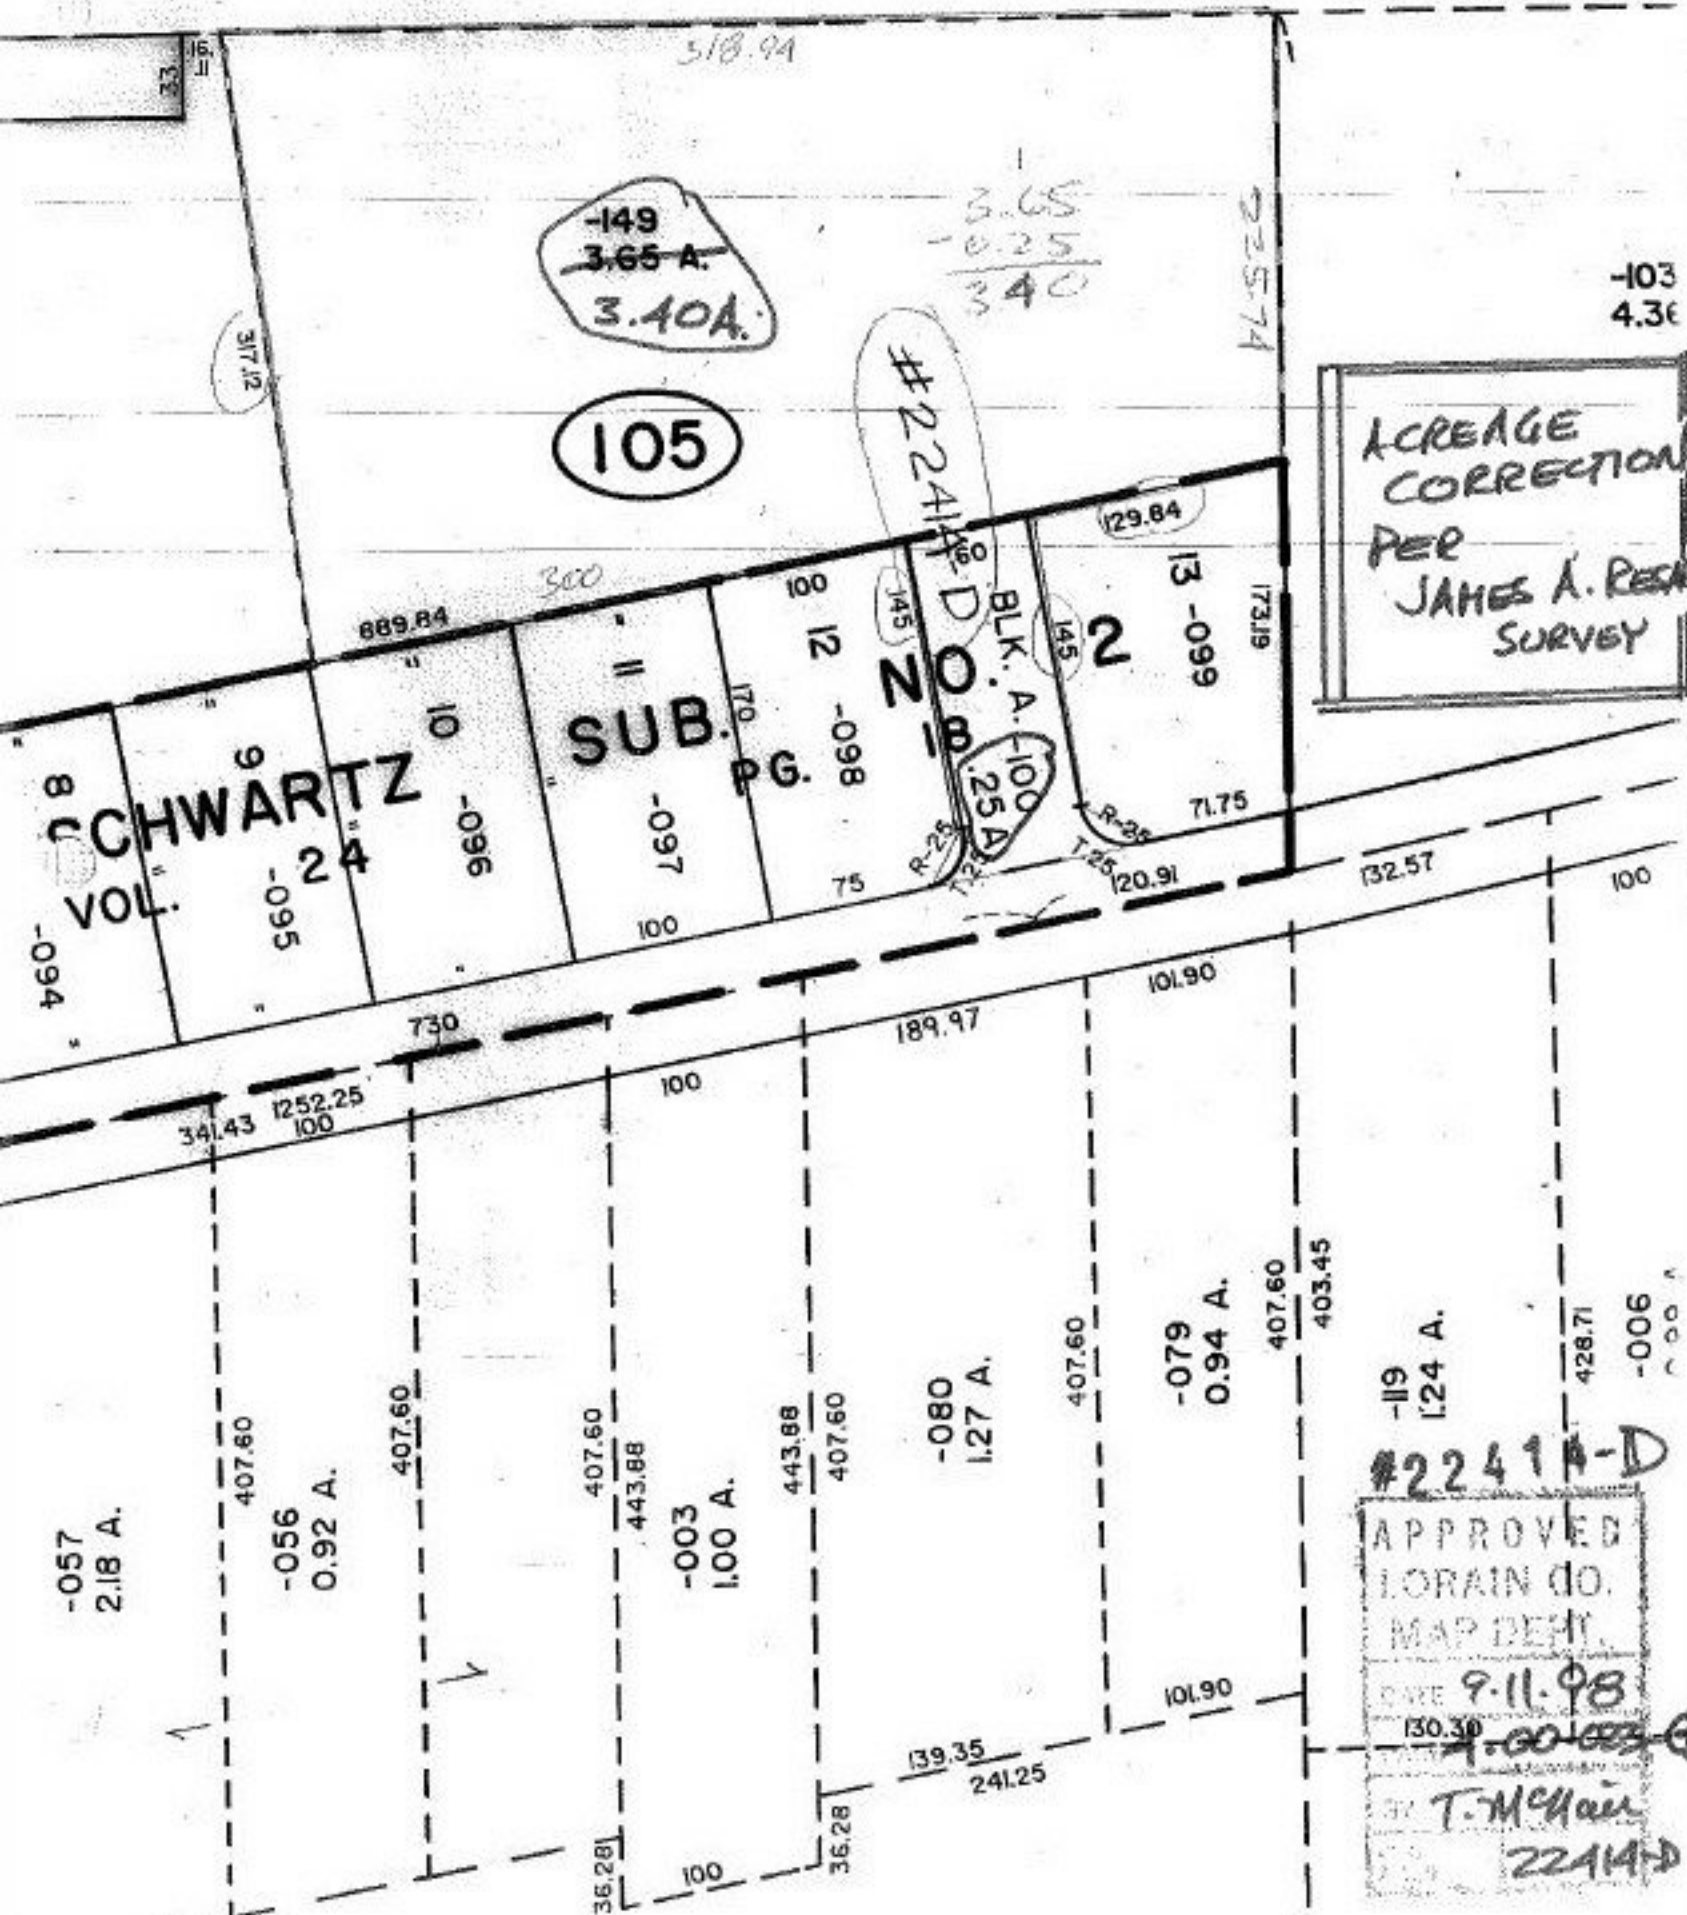

~~-149~~  
~~3.65 A.~~  
 3.40 A.

3.65  
 - 0.25  
 3.40

105

#2241A-D

ACREAGE  
 CORRECTION  
 PER  
 JAMES A. REED  
 SURVEY

8 VOL. SCHWARTZ  
 6  
 24  
 10  
 10  
 12  
 13  
 2

SUB. G.

BLK. A. -100  
 25 A.

-057  
 2.18 A.

-056  
 0.92 A.

-003  
 1.00 A.

-080  
 1.27 A.

-079  
 0.94 A.

-119  
 1.24 A.

#2241A-D  
 APPROVED  
 LORAIN CO.  
 MAP DEPT.  
 DATE 9-11-98  
 130.30  
 4-00-023-G  
 T. McHain  
 2241A-D

-103  
 4.36

100

-006  
 1.00 A.