


PARENT PARCEL: 14-00-057-000-006, 14-00-064-006
 CHILD PARCEL: 14-00-057-000-006, 14-00-064-000-009, 010
 STARTING POINT: cl. of Hughes Rd. & cl. of Hallauer Rd.

NO. 22414

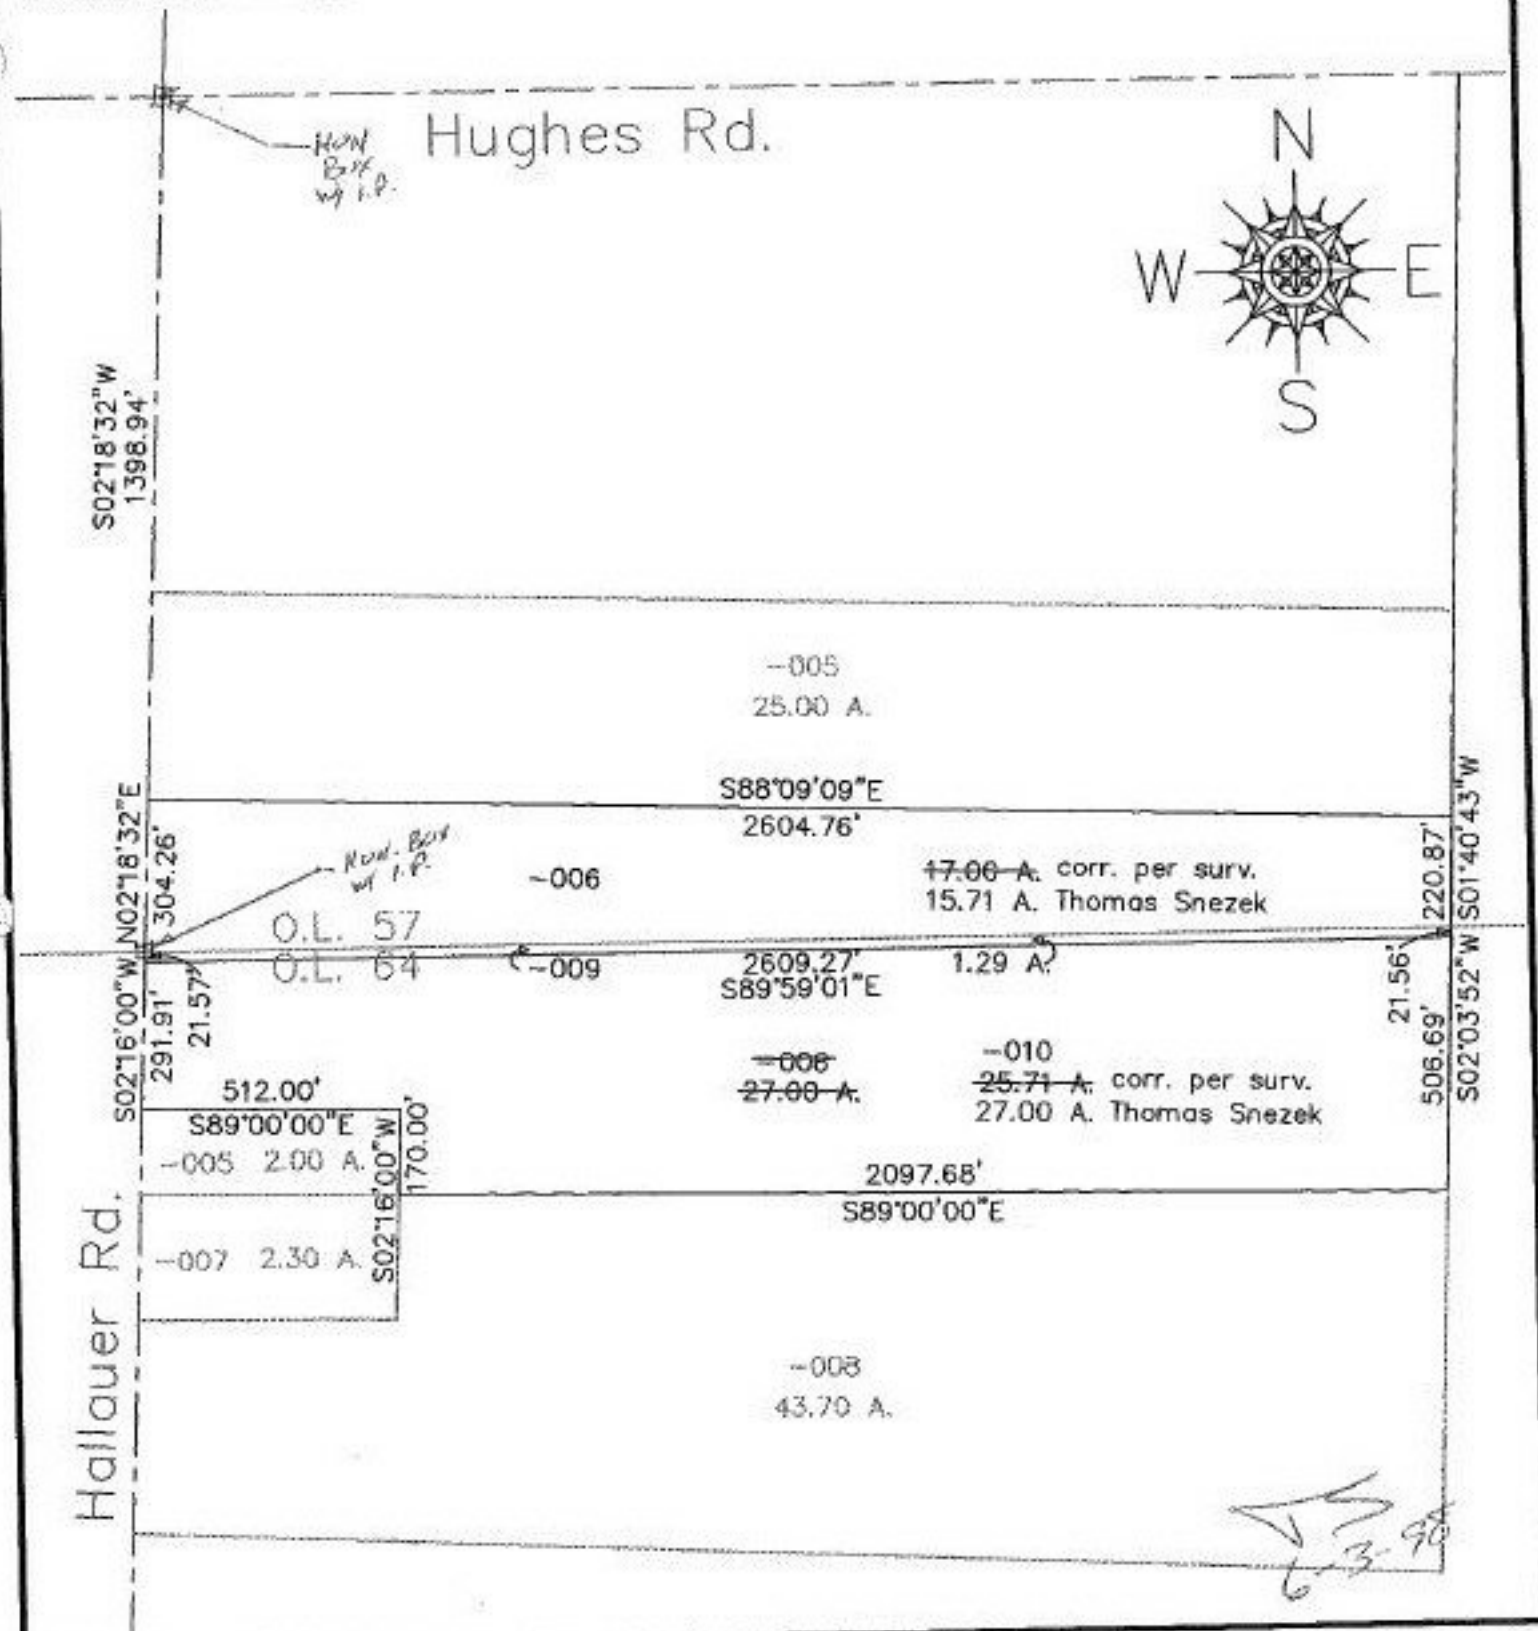

SPLITS/DEEDS PROCESSED
 LORAIN COUNTY TAX MAP DEPARTMENT
 226 MIDDLE AVE. ELYRIA, OHIO

SURVEYED BY: Thomas M. Snezek
 CLOSURE: _____
 MAP PAGE(S): 14-C
 APPROVED BY: kac DATE: 4/2/98
 SCALE: 1" = 400' PRIOR INSTRUMENT: _____