


PARENT PARCEL: 01-00-007-102-010

CHILD PARCEL: 01-00-007-102-013, 014

STARTING POINT: cl. of Baumhart Rd. & cl. of Cleveland-Sandusky Rd.

NO. 22419-X

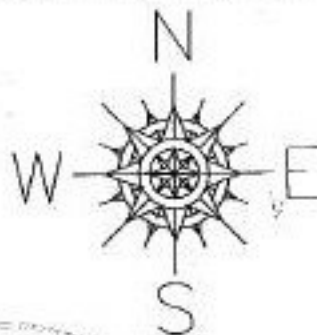

Cleveland-Sandusky Rd.
N 73-51-00 E
920.70

N 00-02-58 E
188.15
pt. - 013
pt. 7.20 A.
809.65
N 81-33-00 W

Baumhart Rd.
S 08-27-00 W
569.39
1269.39
792.46

S 81-33-00 E
706.28
pt. - 013
pt. 7.20 A.
A. - 013
A. 7.20 A

N 00-02-58 E
770.73
corr. per surv.
Rodger G. Simon
245.62
88.32
265
N 81-33-00 W R=130 N 81-33-00 W

1-29-98 THIS PARCEL
WAS SPLIT UNDER RECEIPT
22411 TO
REMOVE HOEK

JS
2-19-99



SPLITS/DEEDS PROCESSED
LORAIN COUNTY TAX MAP DEPARTMENT
226 MIDDLE AVE. ELYRIA, OHIO

SURVEYED BY: Rodger G. Simon
CLOSURE: 0.05:10.000
MAP PAGE(S): 1-0
APPROVED BY: koc DATE: 1/23/98
SCALE: 1" = 300' PRIOR INSTRUMENT: OR 984/455