

PARENT PARCEL: 15-00-062-000-029


CHILD PARCEL: 15-00-062-000-031, 032

STARTING POINT: cl. of Whitney Rd. & cl. of Nickle Plate Diagonal Rd.

NO. 22425



Nickle Plate Diagonal Rd

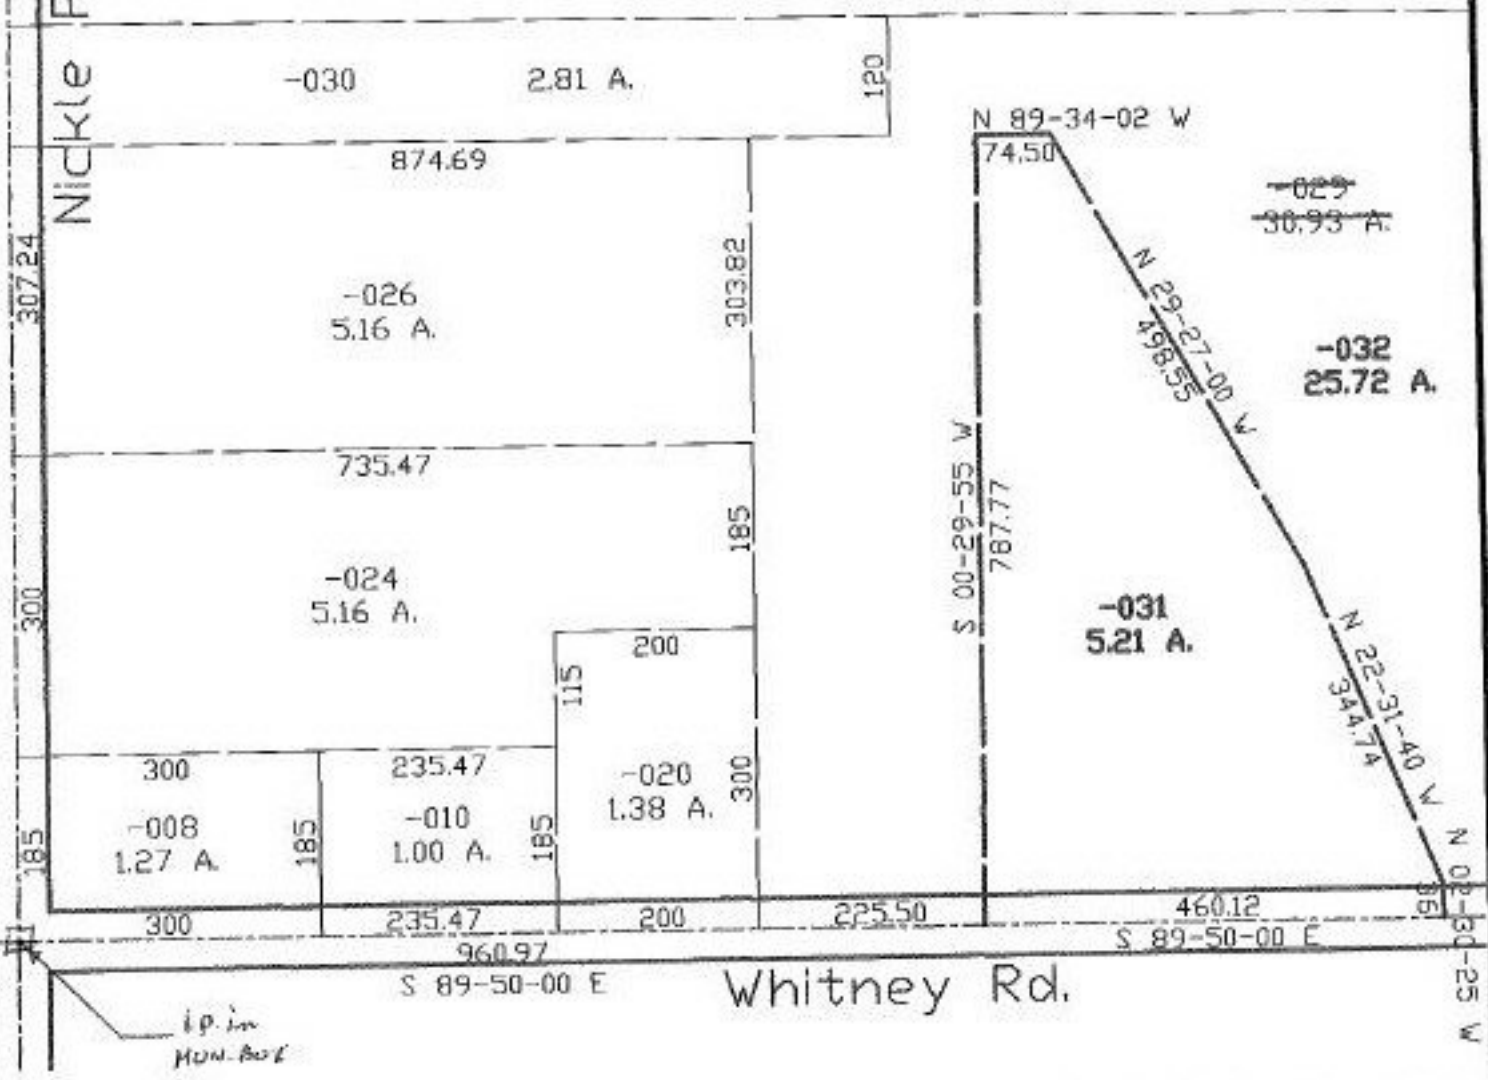

ip in  
Mon. Bot



**SPLITS/DEEDS PROCESSED**  
 LORAIN COUNTY TAX MAP DEPARTMENT  
 226 MIDDLE AVE. ELYRIA, OHIO

SURVEYED BY: Rodger G. Simon L.S.C.  
 CLOSURE: 0.08:10,000  
 MAP PAGE(S): 15-E  
 APPROVED BY: kac DATE: 2/9/98  
 SCALE: 1" = 200' PRIOR INSTRUMENT: 1381/296

1" = 400'