

PARENT PARCEL: 11-00-085-000-054


CHILD PARCEL: 11-00-085-000-059 thru -062

STARTING POINT: cl. of Elyria-Twinsburg & cl. of Durkee Rd.

NO. 22426



Elyria-Twinsburg Rd.

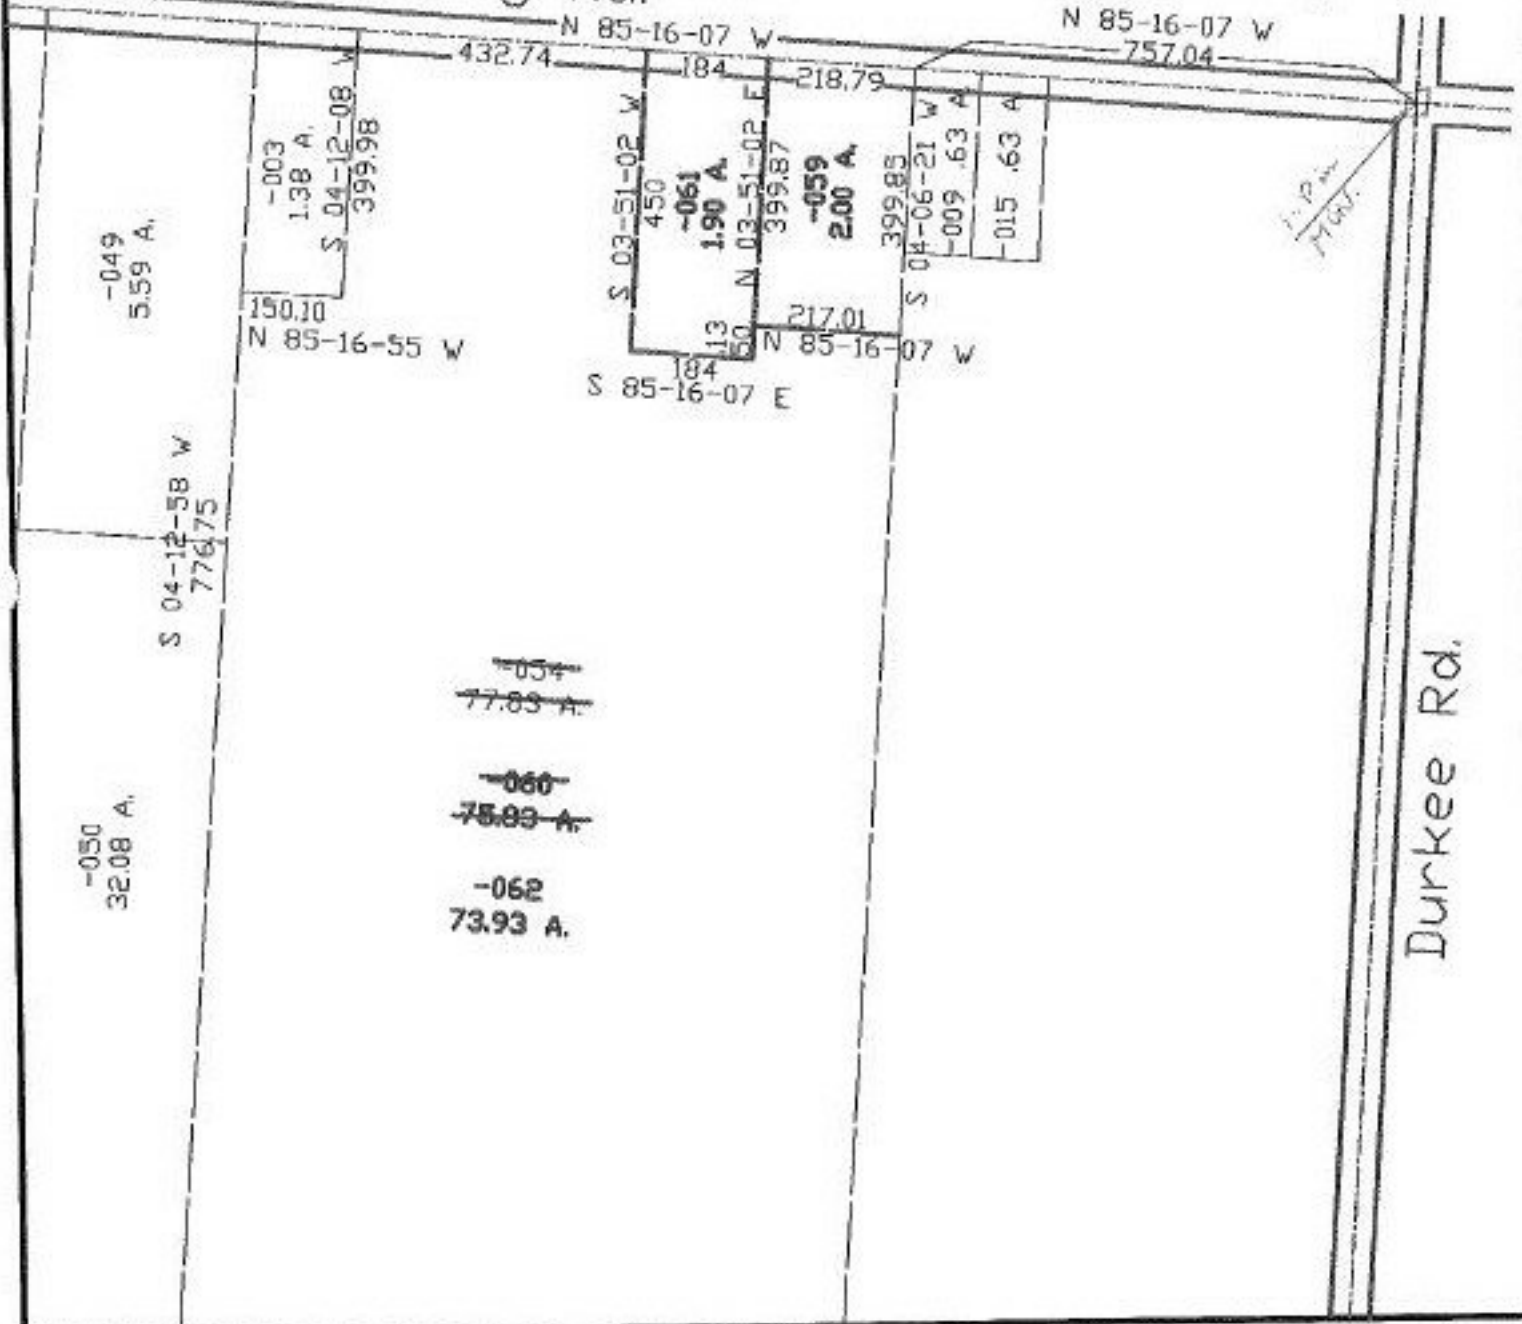

Durkee Rd.



1-28-99

**SPLITS/DEEDS PROCESSED**  
LORAIN COUNTY TAX MAP DEPARTMENT  
226 MIDDLE AVE. ELYRIA, OHIO

SURVEYED BY: David L. Elwell  
CLOSURE: 0.00; 10.000  
MAP PAGE(S): 11-E *Saved North*  
APPROVED BY: kac DATE: 2/3/98  
SCALE: 1" = 300' PRIOR INSTRUMENT: DV 1262/450