

RD.

RD.

1167.54

1167.54

217.80
-005
1.00A
200
217.80

1167.54 (X)


300

-001
50.00 A.

TRANSFER SHEET WAS BEING FILED
INCORRECTLY BUT WAS CORRECTED
AT TIME OF TRANSFER.

REGISTER **OK**
TRANSFER SHEET **OK**
MAP **OK**

DEED **OK** SEE ORV 1368/11

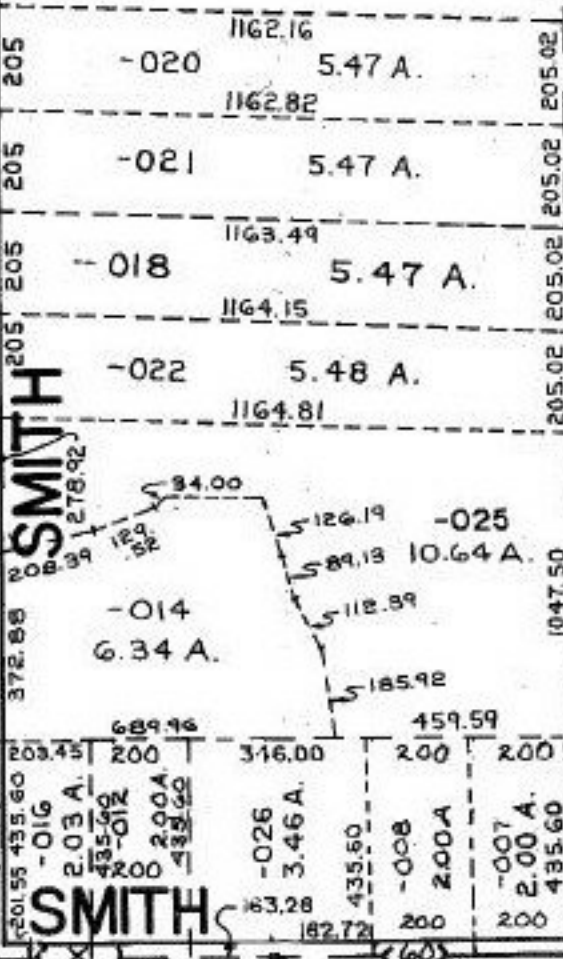

-028
96.00A.

-004
83.00 A.

THIS SPLIT ON
MYLAR AS OF
9-21-98

#22430-A

P.P. No. Corr.

APPROVED
LORAIN CO.
MAP DEPT.
DATE 9-9-98
BY 18-H
T. McMan
NOT DATED
22430-A

1-20-99

RD.