


REDUCED 78%

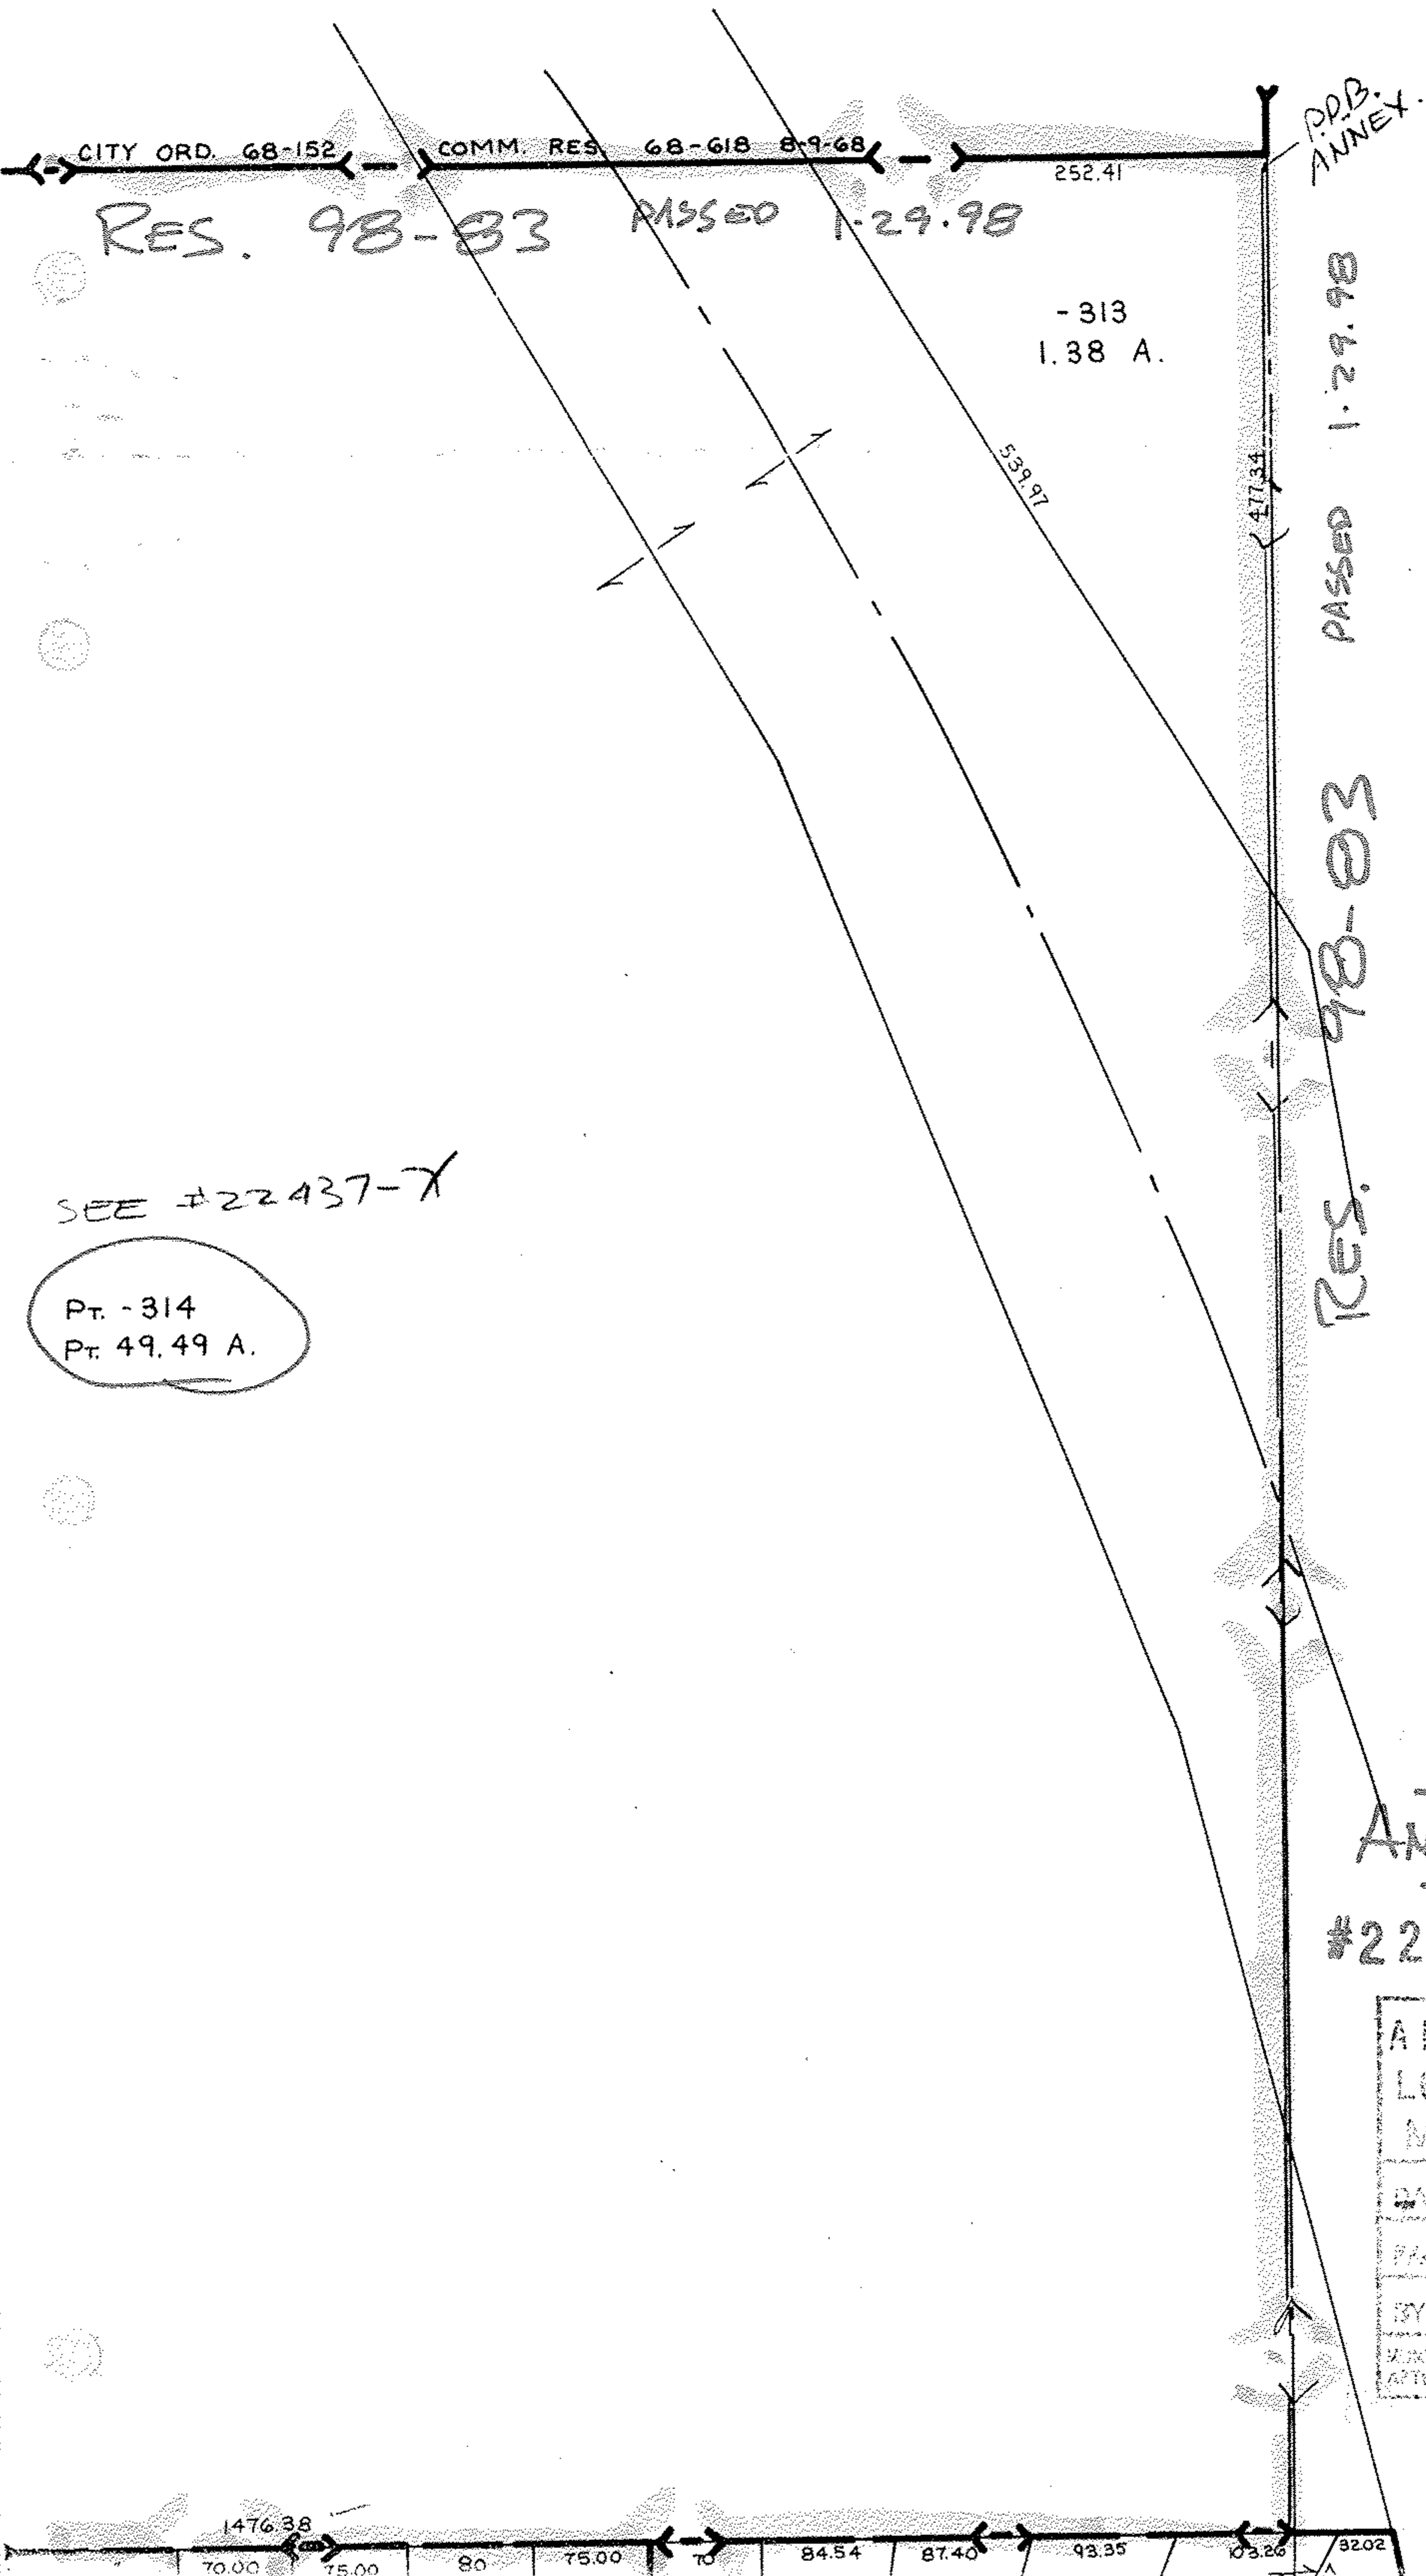

RES. 98-83 PASSED 1-29-98

- 313
1.38 A.

P.D.B.
ANNEX.

RES. 98-83 PASSED 1-29-98

SEE #22437-X

Pt. - 314
Pt. 49.49 A.

ANNEXATION

#22437-X

APPROVED
LORAIN CO.
MAP DEPT.
DATE 1-22-98
PAGE 10.00.05-D
BY T. McHair
SEND AFTER 22437-X

1-A