


PARENT PARCEL: 07-00-032-000-006  
CHILD PARCEL: 07-00-032-000-052, 053  
STARTING POINT: cl. of Barres Rd. & cl. of Stoney Ridge Rd.

NO. 22437

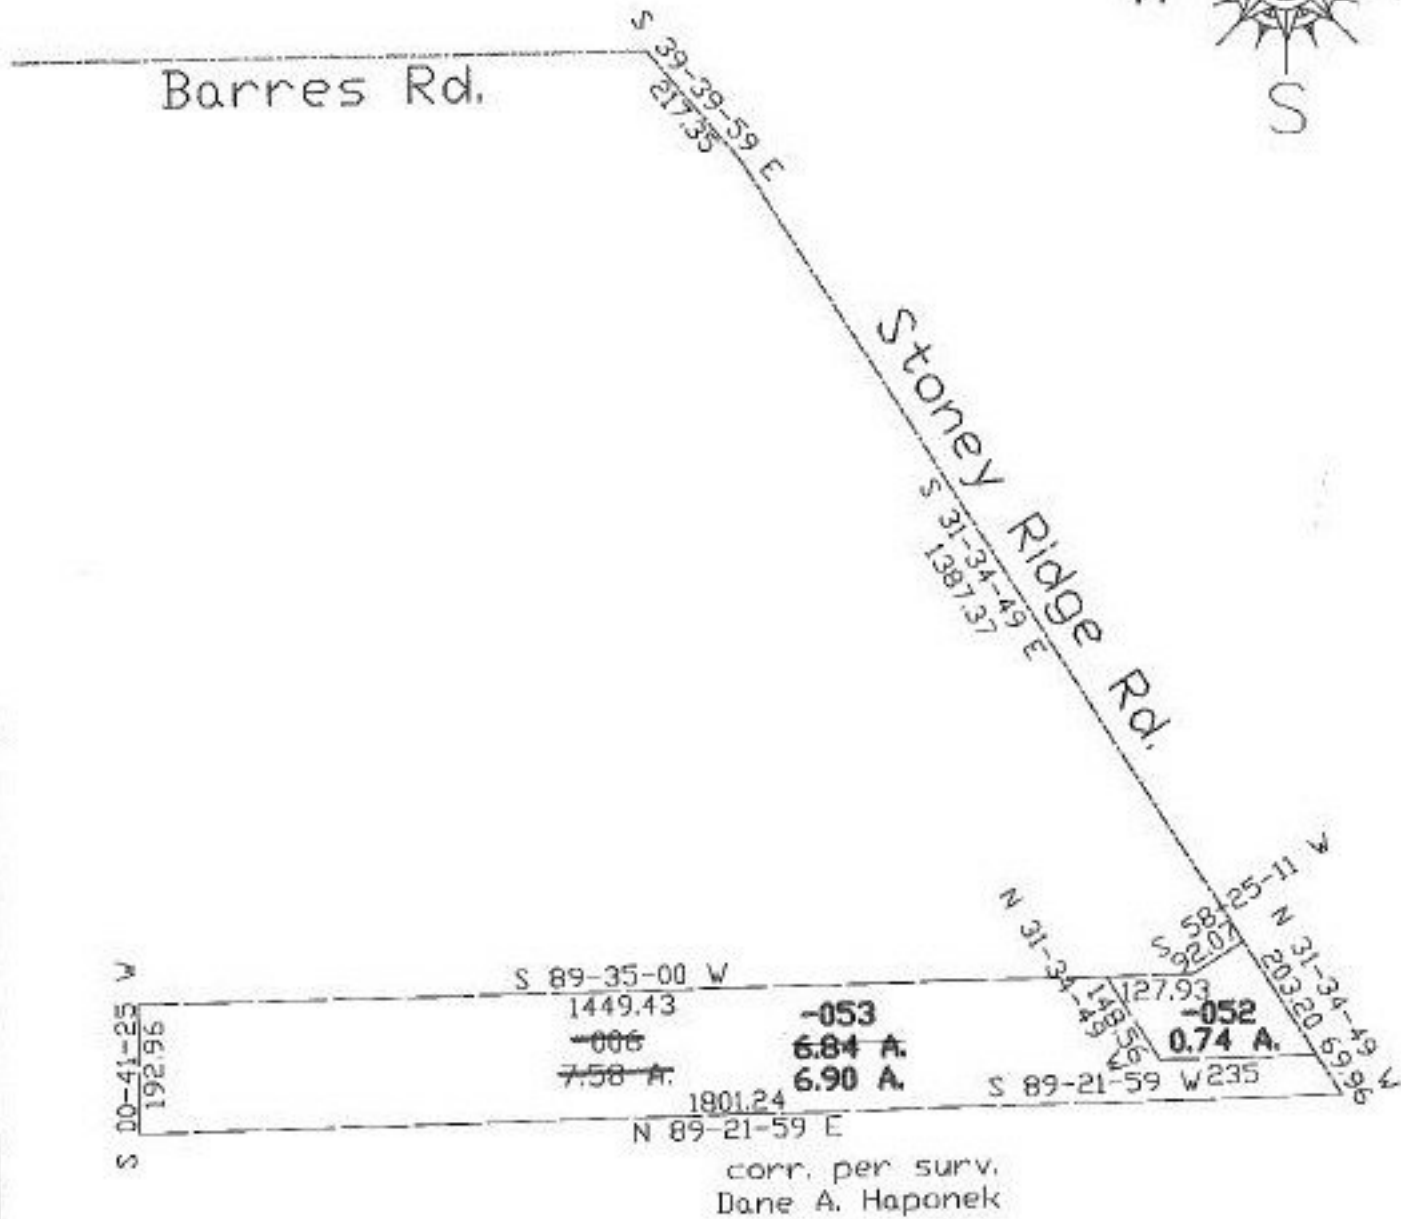

**SPLITS/DEEDS PROCESSED**  
LORAIN COUNTY TAX MAP DEPARTMENT  
226 MIDDLE AVE. ELYRIA, OHIO

SURVEYED BY: Dane A. Haponek  
CLOSURE: 0.03:10,000  
MAP PAGE(S): 7-8  
APPROVED BY: koc DATE: 2/24/98  
SCALE: 1" = 300' PRIOR INSTRUMENT: DV 699/375