


PARENT PARCEL: 15-00-040-000-010

CHILD PARCEL: 15-00-040-000-011, 012

STARTING POINT: cl. of Nickle Plate Diagonal Rd. & SE corner of O.L. 40

NO. 22438

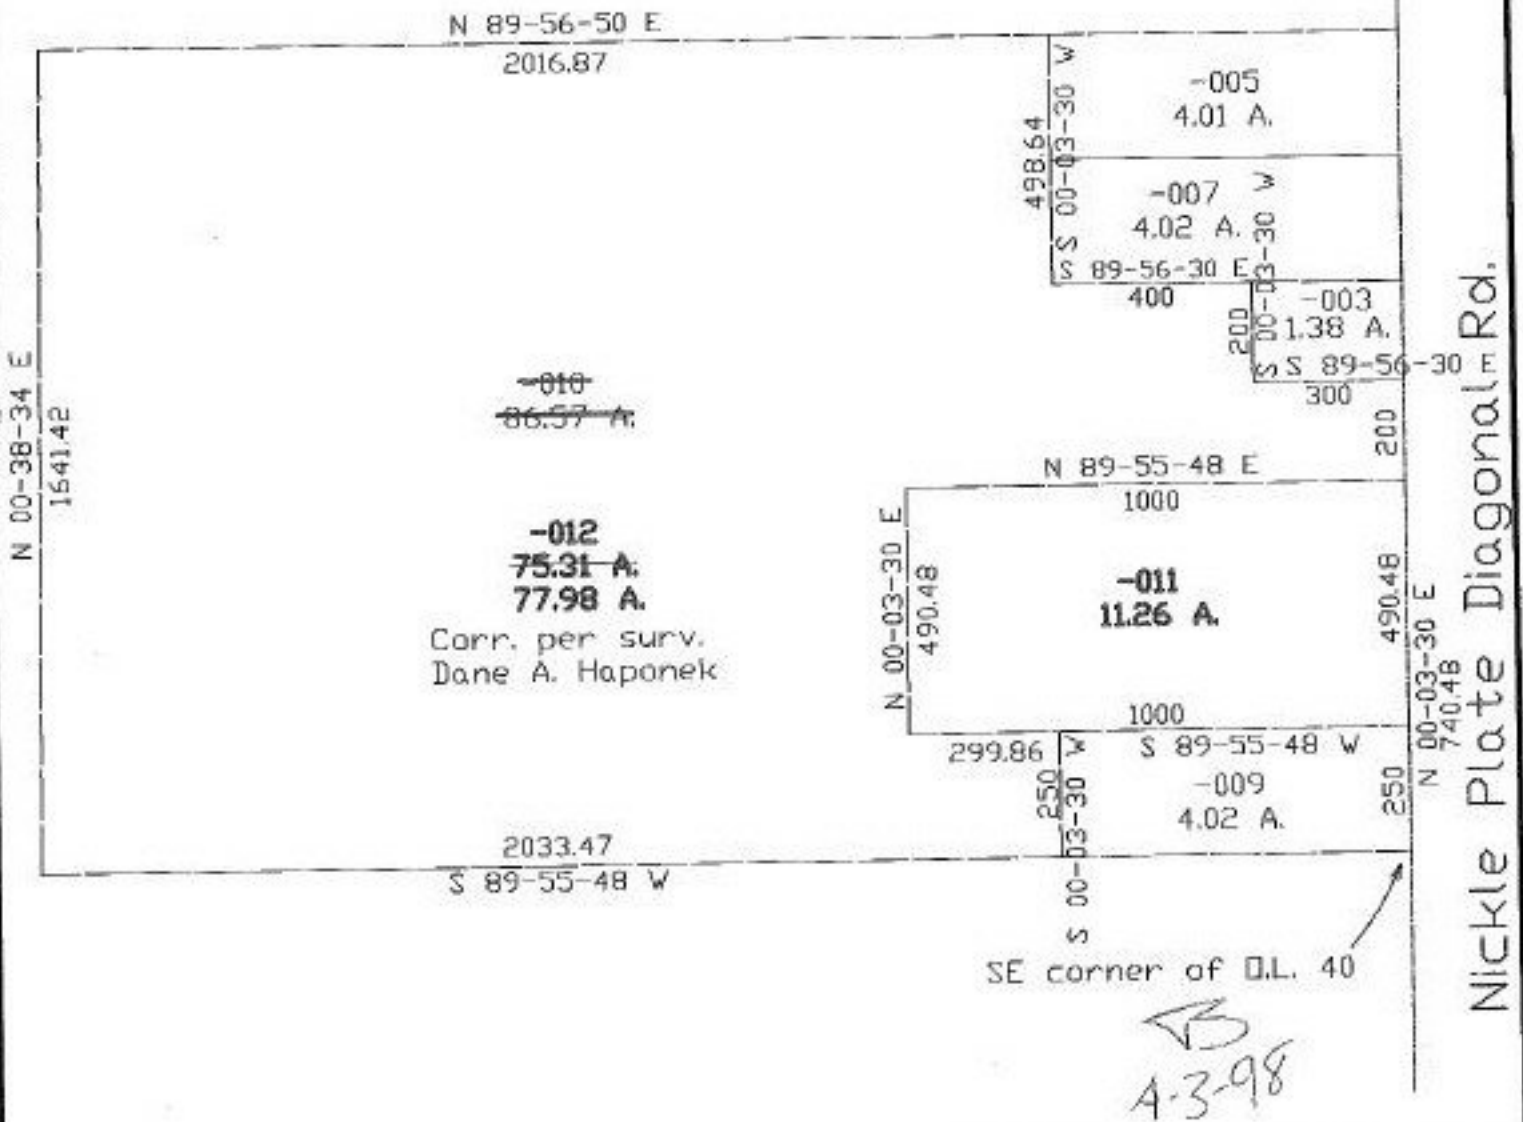

SPLITS/DEEDS PROCESSED
LORAIN COUNTY TAX MAP DEPARTMENT
226 MIDDLE AVE. ELYRIA, OHIO

SURVEYED BY: Dane A. Haponek
CLOSURE: 0.01:10,000
MAP PAGE(S): 15-A
APPROVED BY: kac DATE: 2/24/98
SCALE: 1" = 400' PRIOR INSTRUMENT: #97487868