


PARENT PARCEL: 04-00-011-101-012, 016, 017

CHILD PARCEL: 04-00-011-101-019, 020, 021

STARTING POINT: NW corner of O.L. 11

NO. 22439

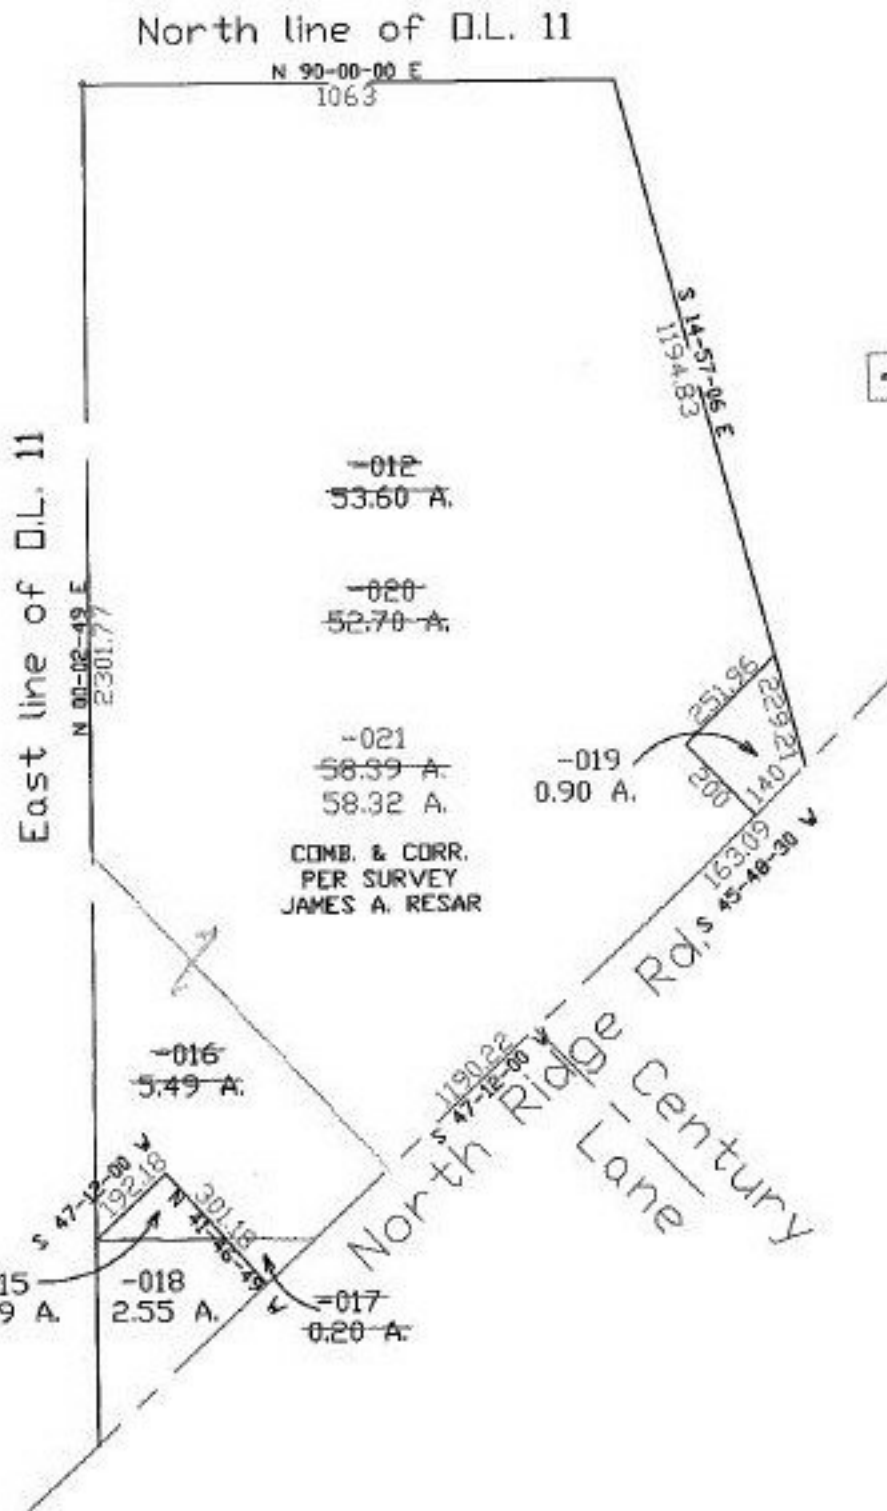

SPLITS/DEEDS PROCESSED

LORAIN COUNTY TAX MAP DEPARTMENT
226 MIDDLE AVE. ELYRIA, OHIO

SURVEYED BY: James A. Resar

CLOSURE: 0.01:10.000

MAP PAGE(S): 04-00-011-A

APPROVED BY: kac DATE: 2/19/98

SCALE: 1" = 400' PRIOR INSTRUMENT:

2-20-98