


PARENT PARCEL: 01-20-026-000-009, 08-00-026-000-005, 08-00-081-000-001  
 CHILD PARCEL: 01-20-026-000-041, 042, 08-00-081-000-030, 031  
 STARTING POINT: c. of Degn Rd. & SW corner of Brownhelm O.L. 26

NO. 22441



- DEED 1: 01-20-026-000-041  
08-00-081-000-030
- DEED 2: 01-20-026-000-042  
08-00-026-000-005  
08-00-081-000-031

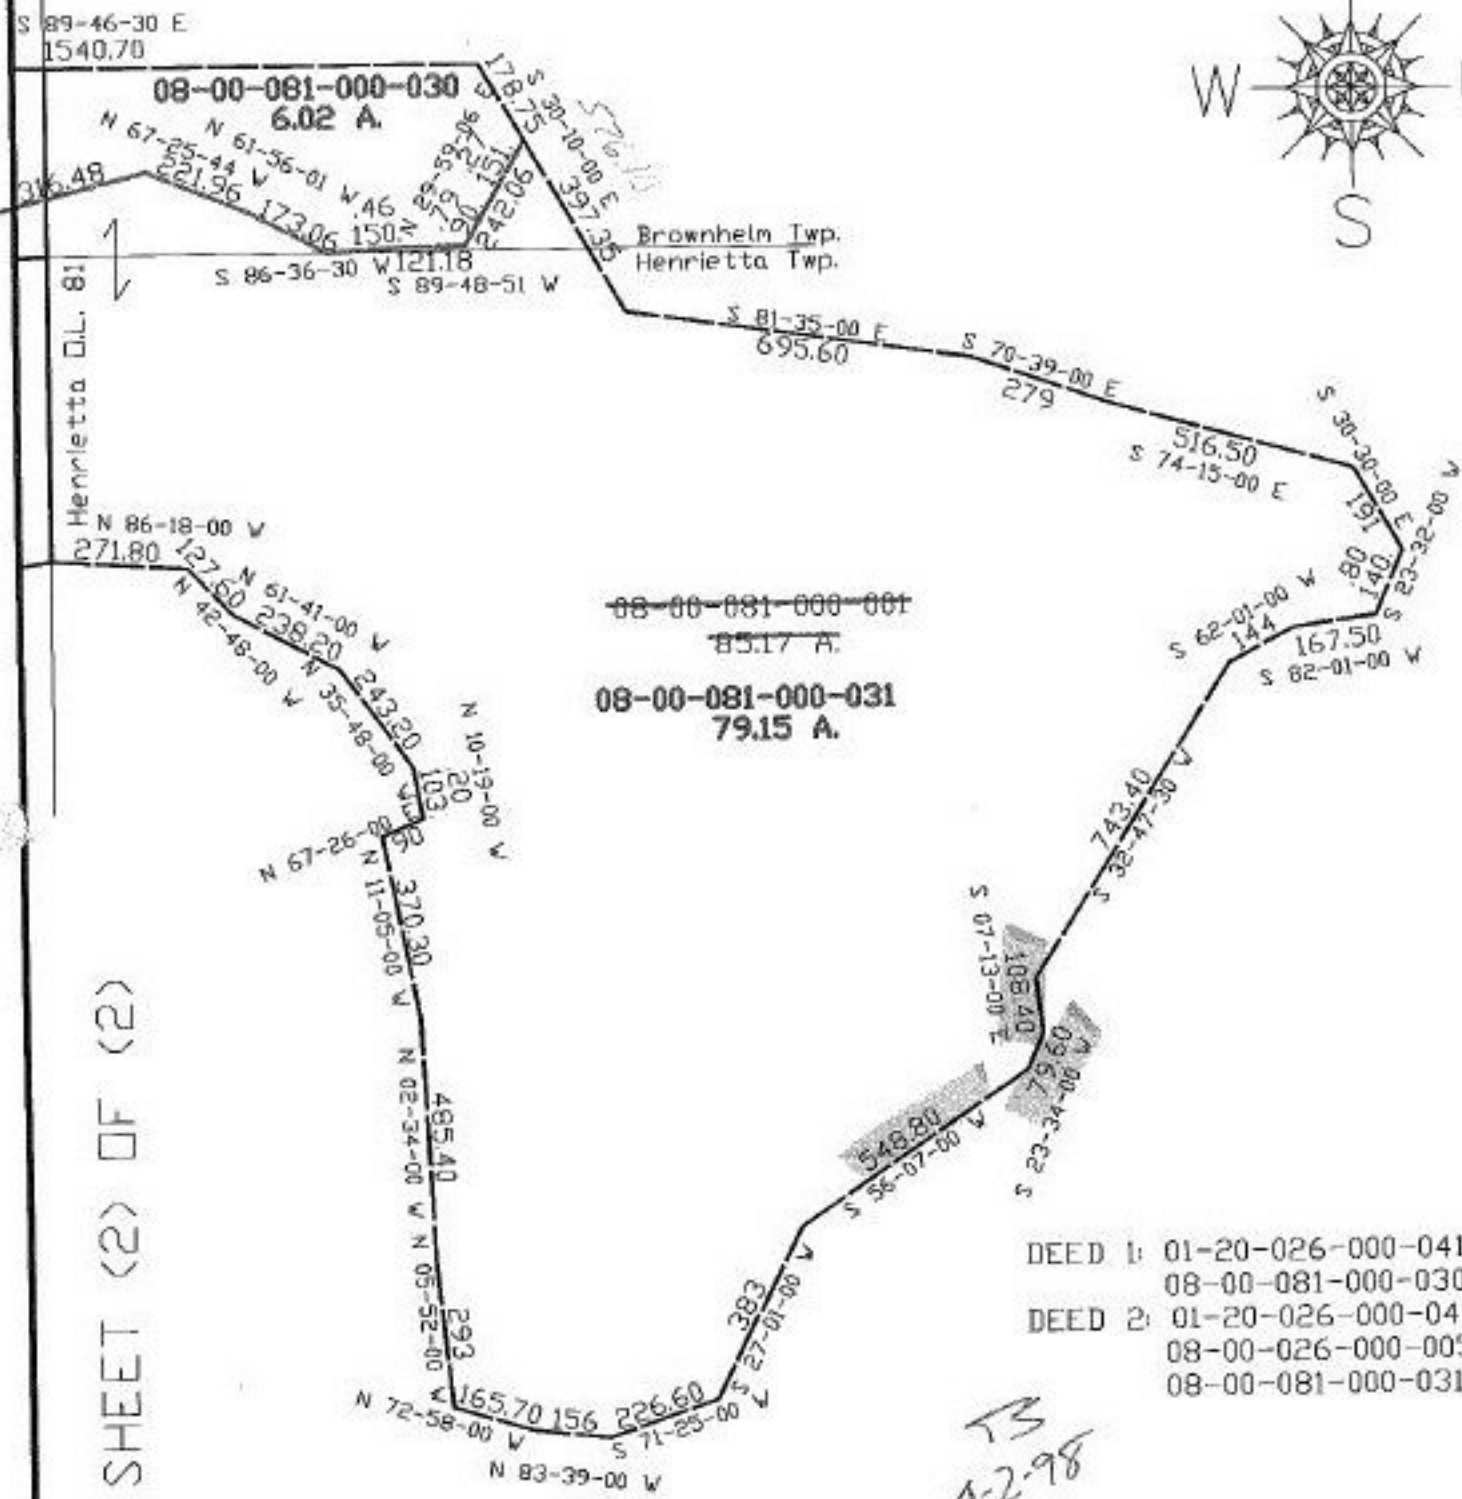

**SPLITS/DEEDS PROCESSED**  
 LORAIN COUNTY TAX MAP DEPARTMENT  
 226 MIDDLE AVE. ELYRIA, OHIO

SURVEYED BY: N.R. Hura  
 CLOSURE: 0.79:10,000  
 MAP PAGE(S): 8-A, 1-1  
 APPROVED BY: kac DATE: 2/24/98  
 SCALE: 1" = 400' PRIOR INSTRUMENT: 1368/517