
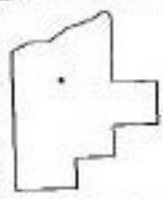


PARENT PARCEL: 03-00-046-101-005

CHILD PARCEL:

STARTING POINT:

NO. 22442-A

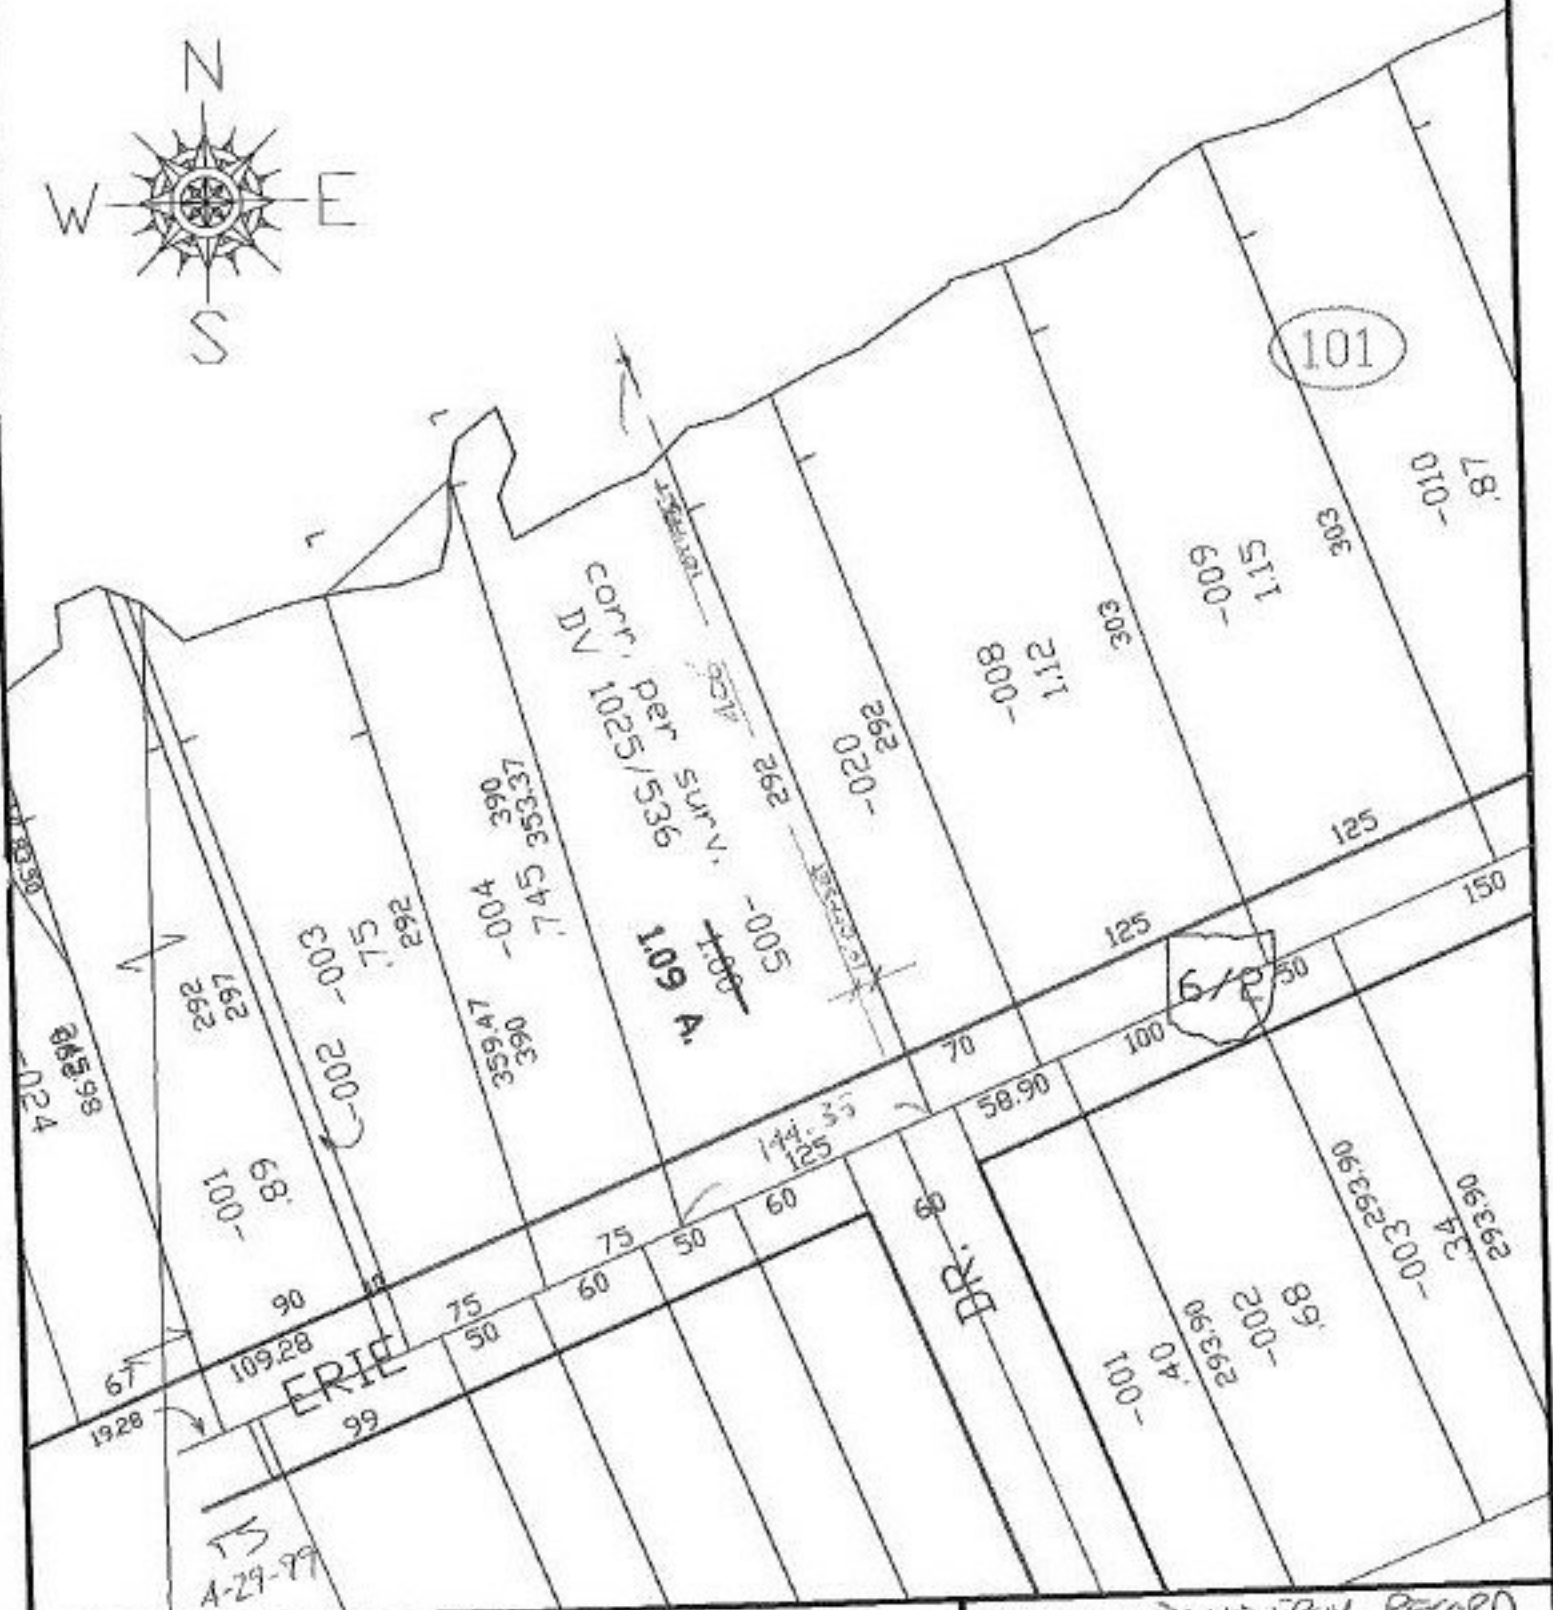

SPLITS/DEEDS PROCESSED

LORAIN COUNTY TAX MAP DEPARTMENT
226 MIDDLE AVE. ELYRIA, OHIO

SURVEYED BY: DONE FROM RECORD
CLOSURE: NOT POSSIBLE - INCOMPLETE
MAP PAGE(S): 3-00-046 A
APPROVED BY: KC DATE: 2/23/98
SCALE: 1" = 100' PRIOR INSTRUMENT DV 1025/536