


PARENT PARCEL: 09-00-012-000-012

CHILD PARCEL: 09-00-012-000-030, 031

STARTING POINT: cl. of Quarry Rd. & cl. of Russia Rd.

NO. 22447

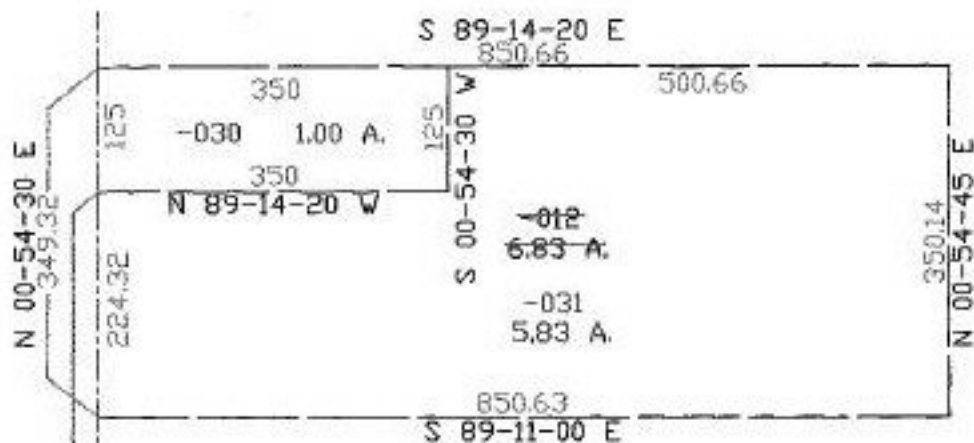

Quarry Rd.

N 00-54-30 E

1344.92

1120.60

Russia Rd.



**SPLITS/DEEDS PROCESSED**

LORAIN COUNTY TAX MAP DEPARTMENT  
226 MIDDLE AVE. ELYRIA, OHIO

SURVEYED BY: Phil A. Rosebeck

CLOSURE: 0.00:10.000

MAP PAGE(S): 09-00-012-A

APPROVED BY: kac DATE: 2/26/98

SCALE: 1" = 200' PRIOR INSTRUMENT: 419/137

3-5-98

Handwritten signature and date: 6/21/99