


PARENT PARCEL: 16-00-061-000-008
 CHILD PARCEL: 16-00-061-000-009, 010, 011
 STARTING POINT: cl. of Law Rd. & W. line of Grafton Twp.

NO. 22452

W. line of Grafton Twp.

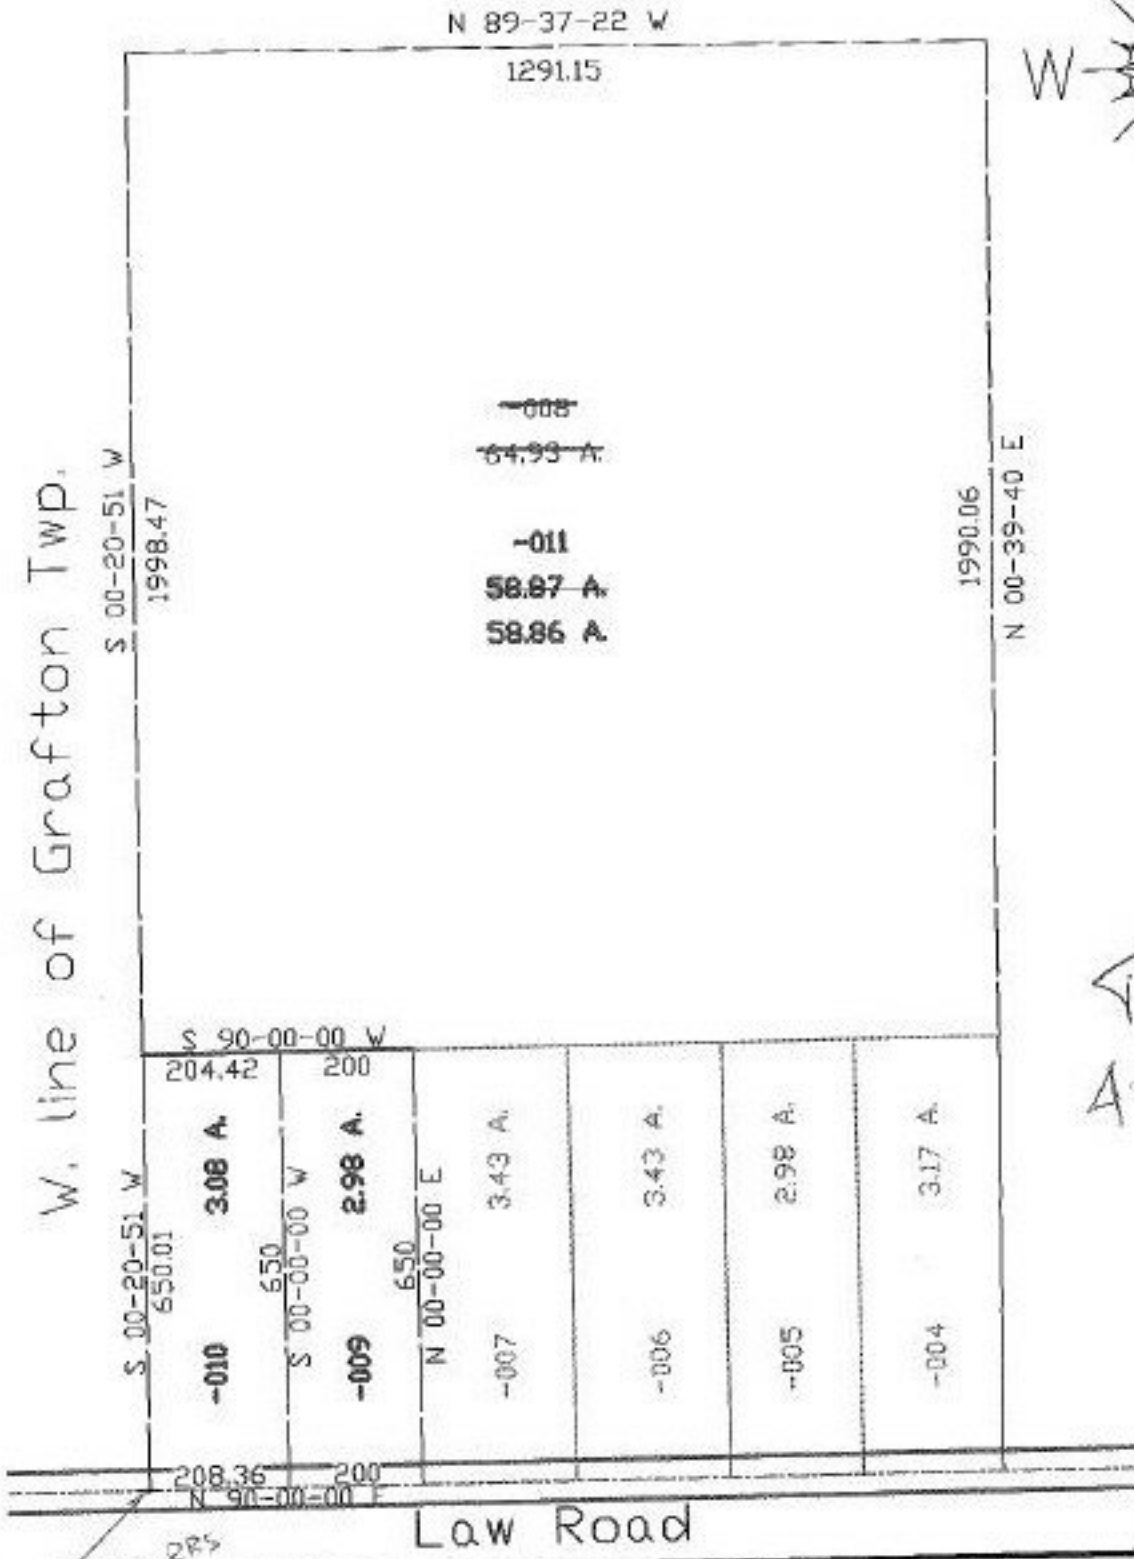

A-3-98



SPLITS/DEEDS PROCESSED
 LORAIN COUNTY TAX MAP DEPARTMENT
 226 MIDDLE AVE. ELYRIA, OHIO

SURVEYED BY: R. G. Simon
 CLOSURE: 0.02:10.000
 MAP PAGE(S): 16-E
 APPROVED BY: kac DATE: 3/4/98
 SCALE: 1" = 300. PRIOR INSTRUMENT: #489252